

MISSISSIPPI DEPARTMENT OF NATURAL RESOURCES

Bureau of Land and Water Resources

Southport Mall

P.O. Box 10631

Jackson, Mississippi 39209

WATER WELL DRILLERS LOG

WAYNE
M. 2018
3/2/81

9

March 2, 1981 Booster Drilling Thayne
date well completed firm name county well located

LANDOWNER: J. M. Miskal
215
Thaynesboro Miss
1 (mailing address)

description of formations encountered	depth	
	from	to
sand	0	8
clay	8	35
sand & clay	35	64
sand	64	120
shaly soft sand		
82' 1" P.V.C. casing pipe		

WELL LOCATION:
sec 8 T 8 N R 8 E
7 miles W of Thaynesboro
(distance) (direction) (nearest town)

WELL PURPOSE: domestic
(home, irrigation, municipal, industrial)

- WELL COMPLETION DATA:
- (1) diameter (inches) 2"
 - (2) total depth (feet) 120'
 - (3) static water level (feet) 65 (below/above top of ground)
 - (4) casing PVC, 115' (material) (depth)
2" (size) if telescope see back.
 - (5) screen 5', 115' (length) (depth to top)
2", 6 slot S.S. (size) (material)
 - (6) pump 1, 8 (HP) (yield gpm)
elec. (type power)
 - (7) electric log no (yes or no)
- (organization running log)

(8) how well/bottom plugged 2' gravel well value

DRILLERS REMARKS:


DEPT. OF NATURAL RESOURCES
BUREAU OF LAND & WATER RESOURCES

MAR - 6 1981

RECEIVED

If well telescopes please sketch and show depths.

GROUND LEVEL

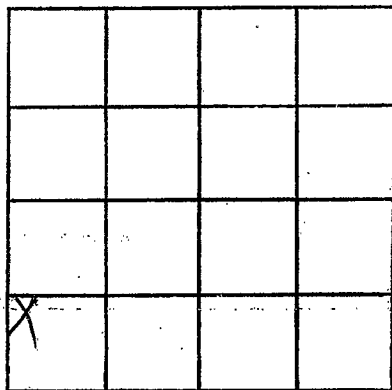

SECTION 23

Please indicate well location X.

ADDITIONAL INFORMATION

If more than one screen,
show locations of each on sketch.