

MISSISSIPPI DEPARTMENT OF NATURAL RESOURCES

Bureau of Land and Water Resources

Southport Mall

P.O. Box 10631

Jackson, Mississippi 39209

WATER WELL DRILLERS LOG

Wayne
M 209

May 3 1982 Porter Drilling & Log Wayne
date well completed firm name county well located

LANDOWNER: <u>William Holman</u>	description of formations encountered	from	to
<u>At 1 Hargreaves Miss</u> (mailing address)	<u>sand & clay</u>	<u>0</u>	<u>33</u>
WELL LOCATION: sec. <u>11</u> T. <u>80</u> (N) R. <u>8</u> (E) <u>6</u> miles (distance) <u>W</u> of <u>Hargreaves</u> (direction) (nearest town)	<u>clay</u>	<u>33</u>	<u>40</u>
WELL PURPOSE: <u>none</u> (home, irrigation, municipal, industrial)	<u>clay & s. sand</u>	<u>40</u>	<u>70</u>
WELL COMPLETION DATA:	<u>sand</u>	<u>70</u>	<u>78</u>
(1) diameter (inches) <u>2"</u>	<u>stone & gravel</u>	<u>78</u>	<u>119</u>
(2) total depth (feet) <u>119'</u>	<u>102' 1" P.V.C. casing</u>		
(3) static water level (feet) <u>88'</u> (below/above top of ground)			
(4) casing <u>PVC</u> <u>1 1/4'</u> (material) (depth)			
(5) screen <u>2"</u> (size) <u>5'</u> (length) <u>1 1/4'</u> (depth to top)			
(6) pump <u>2</u> (HP) <u>10</u> (yield gpm)			
(7) electric log <u>no</u> (yes or no)			
(8) how well bottom plugged <u>2" sand & clay</u>			
DRILLERS REMARKS:			


DEPT. OF NATURAL RESOURCES
BUREAU OF LAND & WATER RESOURCES

JUN 16 1982

RECEIVED

If well telescopes please sketch and show depths.

GROUND LEVEL

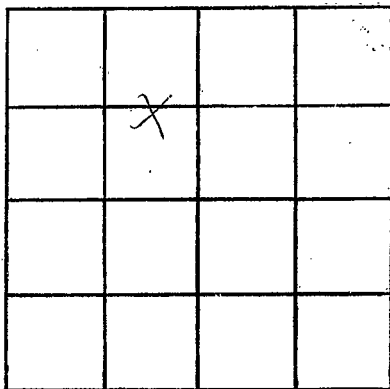

SECTION 11

Please indicate well location X.

ADDITIONAL INFORMATION

If more than one screen,
show locations of each on sketch.