

MISSISSIPPI DEPARTMENT OF NATURAL RESOURCES
Bureau of Land and Water Resources
 Southport Mall
 P.O. Box 10631
 Jackson, Mississippi 39209
WATER WELL DRILLERS LOG

Wayne
M 2020

Jan 27 1983 Bocker Drilling & Log Wayne
 date well completed firm name county well located

LANDOWNER: <u>James Smith</u>	description of formations encountered	from	to
<u>At 1 Stageboro, Ms.</u> (mailing address)			
WELL LOCATION: sec <u>4</u> T <u>2</u> (N) R <u>8</u> E (W) <u>1/4</u> miles <u>S</u> <u>Beal 4 School</u> (distance) (direction) of (nearest town)	<u>clay</u>	<u>0</u>	<u>30</u>
WELL PURPOSE: <u>Home</u> (home, irrigation, municipal, industrial)	<u>fine soft sand</u>	<u>30</u>	<u>38</u>
WELL COMPLETION DATA:	<u>clay</u>	<u>38</u>	<u>50</u>
(1) diameter (inches) <u>2"</u>	<u>soft sand</u>	<u>50</u>	<u>80</u>
(2) total depth (feet) <u>25'</u>	<u>clay</u>	<u>80</u>	<u>120</u>
(3) static water level (feet) <u>27</u> <u>below</u> above top of ground.			
(4) casing <u>PVC</u> , <u>70'</u> (material) (depth)			
<u>2"</u> If telescope see back. (size)			
(5) screen <u>5'</u> <u>70'</u> (length) (depth to top)			
<u>2"</u> , <u>600 S.S.</u> (size) (material)			
(6) pump <u>1</u> <u>12</u> (HP) (yield gpm)			
<u>elec.</u> (type power)			
(7) electric log <u>no</u> (yes or no)			
<u></u> (organization running log)			
(8) how well bottom plugged <u>2" sand screen</u>			
DRILLERS REMARKS:			

42' 1" P.V.C. clay pipe


DEPT. OF NATURAL RESOURCES
 BUREAU OF LAND & WATER RESOURCES

MAY 2 - 1983

RECEIVED

If well telescopes please sketch and show depths.

GROUND LEVEL

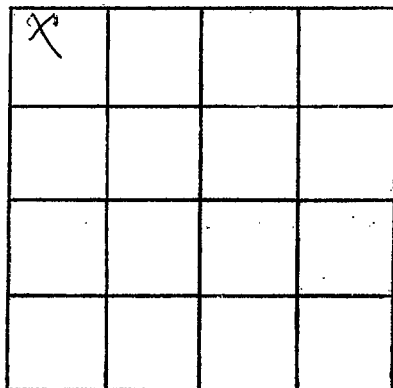

SECTION 4

Please indicate well location X.

ADDITIONAL INFORMATION

If more than one screen, show locations of each on sketch.