

WAYNE

MISSISSIPPI

MISSISSIPPI BOARD OF WATER COMMISSIONERS
416 North State Street
Jackson, Mississippi 39201

WATER WELL DRILLERS LOG

JUNE 19 1984
date well completed

ROY L WEST DR LG
firm name

WAYNE
county well located

LANDOWNER:

FLOYD BUSBY
WAYNESBORO MS
(mailing address)

description of formations encountered

	from	to
TOP SOIL	0	2
SANDY GRAVEL	2	18
CLAY	18	35
SAND	35	84

WELL LOCATION:

sec. 15 $\frac{1}{2}$ N R 8 E
9 miles W of WAYNESBORO
(distance) (direction) (nearest town)

WELL PURPOSE:

(home, irrigation, municipal, industrial)

WELL COMPLETION DATA:

- (1) diameter (inches) 2"
- (2) total depth (feet) 84'
- (3) static water level (feet) 62' below top of ground
- (4) casing PVC (material) (depth) (size) if telescope see back.
- (5) screen 5' (length) 57' (depth to top)
2" (size) PVC (material)
- (6) pump 1 (HP) 8 (yield gpm)
DEA (type power)
- (7) electric log NO (yes or no)

(organization running log)

(8) how well bottom plugged
WAS PLUGGED

DRILLERS REMARKS:


DEPT. OF NATURAL RESOURCES
BUREAU OF LAND & WATER RESOURCES

JUL - 5 1984

RECEIVED

If well telescopes please sketch and show depths.

GROUND LEVEL

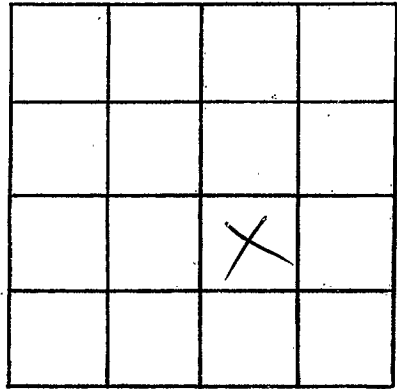

SECTION 15

Please indicate well location X.

ADDITIONAL INFORMATION

If more than one screen, show locations of each on sketch.