

MISSISSIPPI DEPARTMENT OF NATURAL RESOURCES
 Bureau of Land and Water Resources
 Southport Mall
 P.O. Box 10631
 Jackson, Mississippi 39209
WATER WELL DRILLERS LOG

Wayne
M 2002

7/30/86 1986 CARR'S WELL SER. WAYNE
 date well completed firm name county well located

LANDOWNER: ROBERT D. PENS
BT.1 BOX 374 AA
WAYNESBORO MS. 39367
 (mailing address)

description of formations encountered	from	to
SAND	0	8
CHALK	8	20
SD & CLAY	20	25
CLAY	25	70
CHALK SD. STREAKS	70	80
CHALK	80	120
ST. CHALK AND SD.	120	136
FINE TO MED. SD.	136	144

WELL LOCATION:
 sec. 18 T. 8 N. R. 9 E. S. 1
3 miles S. S. E. of WHISLER
 (distance) (direction) (nearest town)

WELL PURPOSE: HOME
 (home, irrigation, municipal, industrial)

- WELL COMPLETION DATA:
- diameter (inches) 3"
 - total depth (feet) 144
 - static water level (feet) 72 below above top of ground.
 - casing P.V.C. 139'
 (material) (depth)
 (size) if telescope see back.
 - screen 5' 139'
 (length) (depth to top)
2" P.V.C.
 (size) (material)
 - pump 1 12
 (HP) (yield gpm)
ELEC.
 (type power)
 - electric log N D
 (yes or no)
 (organization running log)
 - how well bottom plugged SD. TRAP
B. W. V. WITH L.F.H. NIPPLE




AUG 25 1986

Department of Natural Resources
 Bureau of Land & Water Resources

DRILLERS REMARKS:

If well telescopes please sketch and show depths.

GROUND LEVEL

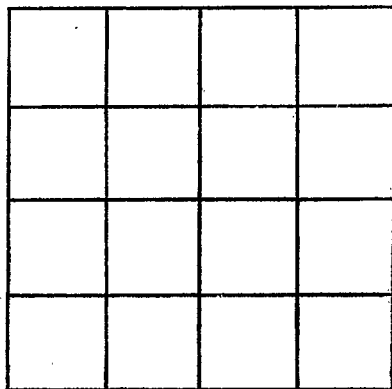

SECTION _____

Please indicate well location X.

ADDITIONAL INFORMATION

If more than one screen,
show locations of each on sketch.