

MISSISSIPPI DEPARTMENT OF ENVIRONMENTAL QUALITY
Bureau of Land and Water Resources

P. O. Box 10631
Jackson, MS 39289-0631
WATER WELL DRILLERS LOG

COUNTY WELL LOCATED WAYNE	
WELL NUMBER M	CODED
DATE WELL COMPLETED 2033 4/2/92	

PERMIT NUMBER 205
NAME OF DRILLING FIRM CARR'S WELL SER
BUCKATUNNA, MS.

NAME & MAILING ADDRESS OF LANDOWNER EDD HARRISON		
RT. 5 BOX 536		
WAYNESBORO, MS. 39367		
WELL LOCATION: SEC	TOWNSHIP	RANGE
31	8	8
DISTANCE _____ Miles	DIRECTION _____	NEAREST TOWN _____
OTHER LANDMARK		
WELL PURPOSE: Home, Irrigation, Municipal, Industrial, Fish Pond, etc. CHICKEN HOUSE		

PUMP DATA		
PUMP TYPE (Circle One): <input checked="" type="checkbox"/> Submersible, <input type="checkbox"/> Turbine, <input type="checkbox"/> Jet, <input type="checkbox"/> Flowing Well, Other (Describe) _____		
POWER TYPE (Circle One): <input checked="" type="checkbox"/> Electric, <input type="checkbox"/> Tractor, <input type="checkbox"/> Diesel, <input type="checkbox"/> Gasoline, <input type="checkbox"/> Butane, Other (Describe) _____ H/P 1/2		
Pump Capacity (GPM) 10	No. of Stages 9	Setting Depth 60 FT.
PUMP TEST		
Well yielded 25 GPM with a drawdown of 28 ft. after 1 hours of pumping		


WELL DATA		
Well Depth 75	Casing Diameter (In.) 4"	Casing Length (Ft.) 65
Type of Casing PVC	Hole Depth 75	Depth to Static Water Level 28'
TYPE OF COMPLETION: (Circle One or More): <input checked="" type="checkbox"/> Gravel Packed, <input type="checkbox"/> Underreamed, <input type="checkbox"/> Telescoped, <input checked="" type="checkbox"/> Natural Development, <input type="checkbox"/> Open Hole, <input type="checkbox"/> Other _____ (Describe) _____		
Top of Lap Pipe or Reduction in Casing FEET IF TELESCOPED OR MORE THAN ONE SCREEN: USE BACK PAGE		

LOG DATA	
TYPE OF LOG RUN (Circle One): <input type="checkbox"/> No Log Run, <input type="checkbox"/> Electric, <input type="checkbox"/> Gamma Ray, <input type="checkbox"/> Density, <input type="checkbox"/> Sonic, <input type="checkbox"/> Neutron, Other (Describe) _____	
Name of Organization Running Log	

SCREEN DATA		
Diameter - Inches 4"	Length - Feet 10'	Slot Size - Inches 8
Screen Type PVC	Depth to Bottom - Feet 75	

GEOLOGIC DATA (Office Use Only)			
Surface Elev.	Geologic Unit	Unit Thickness	Depth to Top
Subs. SWL	Date	Analysis	Aquifer Test
Driller's Remarks			

DESCRIPTION OF FORMATIONS ENCOUNTERED	FROM	TO	FORMATIONS (Continued)	
			FROM	TO
TOP SO:1	0	1		
SANDY CLAY	1	10		
PK & GRAY CLAY	10	30		
LN. TO MED. SD.	30	54		
LN. SD & CLAY	54	60		
LN. WH. SD.	60	66		
MED. TO LR. SD.	66	75		

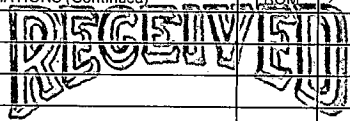

MAY 01 1992

Dept. of Environmental Quality
Bureau of Land & Water Resources

IF MORE SPACE IS NEEDED, USE BACK

If well telescopes please
sketch and show depths.

GROUND LEVEL

SECTION _____

Please indicate well location X.

ADDITIONAL INFORMATION

If more than one screen,
show location of each on sketch.