

MISSISSIPPI DEPARTMENT OF NATURAL RESOURCES

Bureau of Land and Water Resources

Southport Mall

P.O. Box 10631

Jackson, Mississippi 39209

WATER WELL DRILLERS LOG

Wayne  
~~Wayne~~  
 M 2039

April 6 1982 date well completed  
 82 Porth Drilling & Pump firm name  
 Itaska county well located

LANDOWNER: Larry Bushy  
 Rt 5 Haynesboro

description of formations encountered	from	to
sand	0	8
Clay	8	35
Clay & sand	35	101
sand	101	126
shale & white still in sand		
82' 1" P.V.C drop pipe		

(mailing address)

WELL LOCATION:  
 sec. 14 T 2 S R 8 E  
 6 miles W of Haynesboro  
 (distance) (direction) (nearest town)

WELL PURPOSE: Home  
 (home, irrigation, municipal, industrial)

WELL COMPLETION DATA:

(1) diameter (inches) 2"

(2) total depth (feet) 12.3'

(3) static water level (feet) 64' below top of ground.

(4) casing: P.V.C. 118' (material) (depth)  
 2" (size) if telescope see back.

(5) screen: 5' 118' (length) (depth to top)  
 2" (size) below S.S. (material)

(6) pump: 1 1/2 (HP) 1.2 (yield gpm)  
 elec. (type power)

(7) electric log no (yes or no)  
 (organization running log)

(8) how well bottom plugged  
 2 sand shale

DRILLERS REMARKS:


DEPT. OF NATURAL RESOURCES  
 BUREAU OF LAND & WATER RESOURCES

APR 20 1982

RECEIVED

If well telescopes please sketch and show depths.

GROUND LEVEL

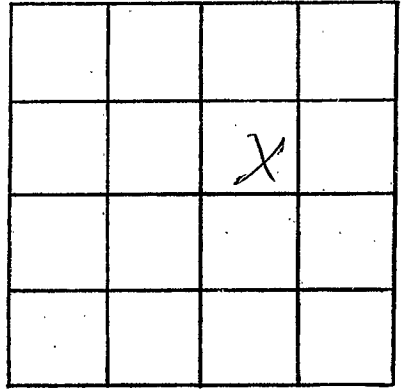

SECTION 14

Please indicate well location X.

ADDITIONAL INFORMATION

Lined area for additional information.

If more than one screen, show locations of each on sketch.