

WAYNE MISSISSIPPI BOARD OF WATER COMMISSIONERS

N4

4-15-64


WATER WELL DRILLERS LOG

Date: April 15, 1964, Driller: Peter Drilling & Pipe County Wayne  
 (Name)

(1) Owner of Land: William O. Lee  
 (Name)  
at 3 Waynesboro, Miss  
 (Address)  
 (2) Location: SW 1/4, NW 1/4, Sec. 19 T8 R7  
7 miles S.W of Waynesboro  
 (distance) (direction) (Nearest Town)  
 (3) Topography: hilly  
 (Hilly) (Flat) (Level)  
 (4) Purpose of Well: domestic  
 (Domestic Irrigation  
 Municipal, Industrial, Other)

Description & Color of Materials Sand, Clay, Red Clay, Shell, etc.	Thick- ness Feet	Depth Feet
red clay	10	10
sand	4	14
chalk	106	120
fine sand with streaks of chalk	85	205
blue chalk	45	250
streaks of rock	37	287
brown chalk	10	297
streaks of sand & chalk	6	303
very clean sand	10	313
chalk & sand streaks	10	323
course sand	<del>10</del>	332
blue chalk	50	382
reduce hole to 3 3/4"		382
honeycombed	27	409
white chalk	3	412

Information upon completion of well:  
4" X 2"  
 (1) Diameter 2 inches.  
 (2) Total Depth 412 feet.  
 (3) Water Level 132' feet below top of ground.  
 (4) Cased to 213', Size 4"  
382' 2" pipe  
 (5) Screen: Size none, Length \_\_\_\_\_  
 (6) Were any formations sealed against pollution?  
X yes, \_\_\_\_\_ no.  
 If YES depth of formation 126'  
 Why seal off cavity  
 Drillers Remarks: 3/4 HP submers at 189'

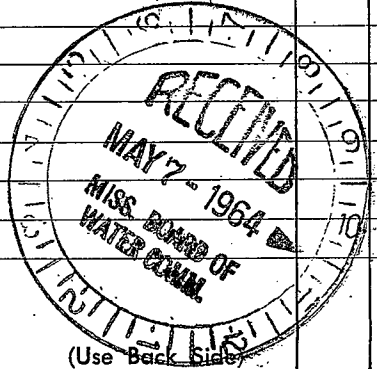

Well No.

