

N7

6-30-64

WATER WELL DRILLERS LOG


Date: June 30, 1964, Driller: Porter Drilling Co County: Wayne  
(Name)

(1) Owner of Land: Grand Lee  
(Name)  
At 3 Waynesboro, Miss  
(Address)  
(2) Location: SW 1/4, SW 1/4, Sec. 18 T. 8 R. 7  
6 miles west of Waynesboro  
(distance) (direction) (Nearest Town)  
(3) Topography: hilly  
(Hilly) (Flat) (Level)  
(4) Purpose of Well: domestic  
(Domestic Irrigation  
Municipal, Industrial, Other)

Description & Color of Materials Sand, Clay, Red Clay, Shell, etc.	Thick- ness Feet	Depth Feet
red clay	10	10
sand	5	15
chalk	5	20
sand & chalk	5	25
sand	24	49
chalk	11	60
thin rock		60
chalk	32	92
thin rock		92
tight sand & chalk	23	115
chalk	15	130
sand	10	140
chalk	6	146
tight sand	4	150
loose sand	55	205
rough soft rock		205
blue chalk	51	256
rock strata	9	265
blue chalk	7	272
strata of rock	18	290
blue chalk	30	320
clean washed sand	8	328
blue chalk	52	380
honeycom rock	25	405
white chalk	7	412

Information upon completion of well:

(1) Diameter 2" inches.  
(2) Total Depth 412' feet.  
(3) Water Level 162' feet below top of ground.  
(4) Cased to 380', Size 2"  
(5) Screen: Size \_\_\_\_\_, Length \_\_\_\_\_  
none  
(6) Were any formations sealed against pollution?  
\_\_\_\_\_ yes, X no.  
If YES depth of formation \_\_\_\_\_  
Why \_\_\_\_\_  
Drillers Remarks: Jet

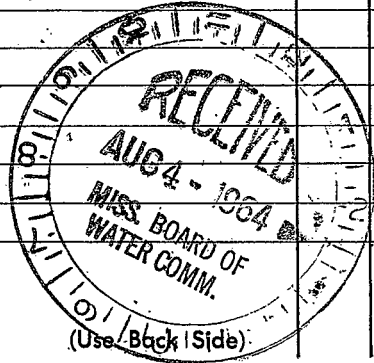

Well No.

