

N 9

WATER WELL DRILLERS LOG

4-21-64

Date: April 21, 1964, Driller: Bohrer Drilling Co County Wayne  
 (Name)

(1) Owner of Land: Mrs. Nancy Clark  
 (Name)  
At 3 Hargreshov  
 (Address)  
 (2) Location: SE 1/4, SE 1/4, Sec. 34 T 8 R 7,  
5 miles south of Hargreshov  
 (distance) (direction) (Nearest Town)  
 (3) Topography: hilly  
 (Hilly) (Flat) (Level)  
 (4) Purpose of Well: domestic  
 (Domestic Irrigation, Municipal, Industrial, Other)


Description & Color of Materials Sand, Clay, Red Clay, Shell, etc.	Thick- ness Feet	Depth Feet
Chalk	15	15
sand & chalk	10	25
sand rock		25
fine red sand	6	31
sand rock		31
sand chalk	15	46
blue chalk	7	53
fine sand	4	57
chalk	12	69
light sand	5	74
chalk	9	83
sand rock	3	86
Chalk	32	118
rock		118
Chalk blue	38	156
red sand	6	162
Chalk & sand streak	37	199
blue Chalk	18	216
blue sand mixed with sea shell stapled on chalk	6	222

Information upon completion of well:

(1) Diameter 2" inches.  
 (2) Total Depth 222' feet.  
 (3) Water Level 66' feet below top of ground.  
 (4) Cased to 199', Size 2"  
 (5) Screen: Size 1/4", Length 6'  
60 ga  
 (6) Were any formations sealed against pollution?  
no

If YES depth of formation \_\_\_\_\_  
 Why \_\_\_\_\_

Drillers Remarks: \_\_\_\_\_

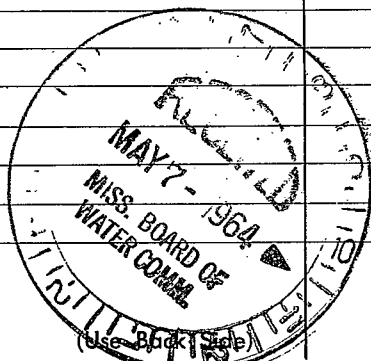

Well No.

