

N10

12-3-63

WATER WELL DRILLERS LOG

Date: Dec 3, 1963, Driller: Porter Drilling & Log Co County Wayne  
 (Name)


(1) Owner of Land: Marvin Jarrier  
 (Name)  
Rt 3 N Waynesboro  
 (Address)  
 (2) Location: NW 1/4, NW 1/4, Sec 35 T8 R7  
4 miles south of Waynesboro  
 (distance) (direction) (Nearest Town)  
 (3) Topography: hilly  
 (Hilly) (Flat) (Level)  
 (4) Purpose of Well: domestic  
 (Domestic Irrigation  
 Municipal, Industrial, Other)

Description & Color of Materials Sand, Clay, Red Clay, Shell, etc.	Thick- ness Feet	Depth Feet
<u>red clay</u>	<u>12</u>	<u>12</u>
<u>sand</u>	<u>23</u>	<u>35</u>
<u>chalk</u>	<u>5</u>	<u>40</u>
<u>red sand</u>	<u>21</u>	<u>61</u>
<u>chalk</u>	<u>3</u>	<u>64</u>
<u>sand</u>	<u>2</u>	<u>66</u>
<u>chalk</u>	<u>3</u>	<u>69</u>
<u>sand</u>	<u>15</u>	<u>84</u>
<u>med clean sand</u>	<u>14</u>	<u>98</u>
<u>red sand</u>	<u>3</u>	<u>101</u>

Information upon completion of well:

(1) Diameter 2" inches.  
 (2) Total Depth 101' feet.  
 (3) Water Level 80' feet below top of ground.  
 (4) Cased to 90', Size 2"  
 (5) Screen: Size 1/4", Length 5'  
Johnson S.S.  
 (6) Were any formations sealed against pollution?  
yes, X no.

If YES depth of formation \_\_\_\_\_  
 Why \_\_\_\_\_  
 Drillers Remarks: \_\_\_\_\_

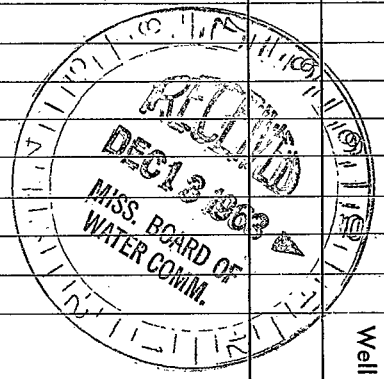

(Use Back Side)

Well No.

