

N 12  
7-9-63

WATER WELL DRILLERS LOG

Date: May 9, 1963, Driller: Porter Drilling & Svc County Wayne  
(Name)

(1) Owner of Land: Wilbur Martin  
(Name)  
Waynesboro Miss.  
(Address)

(2) Location: SE 1/4, NW 1/4, Sec. 11 T8 R7,  
1/2 miles west of Waynesboro  
(distance) (direction) (Nearest Town)

(3) Topography: flat  
(Hilly) (Flat) (Level)

(4) Purpose of Well: domestic  
(Domestic Irrigation  
Municipal, Industrial, Other)

Description & Color of Materials Sand, Clay, Red Clay, Shell, etc.	Thick- ness Feet	Depth Feet
<u>fill</u>	<u>8</u>	<u>8</u>
<u>chalk</u>	<u>4</u>	<u>12</u>
<u>sand</u>	<u>5</u>	<u>17</u>
<u>blue chalk</u>	<u>5</u>	<u>22</u>
<u>strata of lime rock</u>		
<u>&amp; blue chalk</u>	<u>46</u>	<u>68</u>
<u>blue chalk</u>	<u>36</u>	<u>104</u>
<u>honeycomb rock</u>	<u>26</u>	<u>130</u>
<u>white chalk</u>	<u>5</u>	<u>135</u>

Information upon completion of well:

(1) Diameter 2" inches.


(2) Total Depth 135' feet.

(3) Water Level 20' feet below top of ground.

(4) Cased to 104, Size 2"

(5) Screen: Size none, Length \_\_\_\_\_

(6) Were any formations sealed against pollution?  
\_\_\_\_\_ yes, X no.

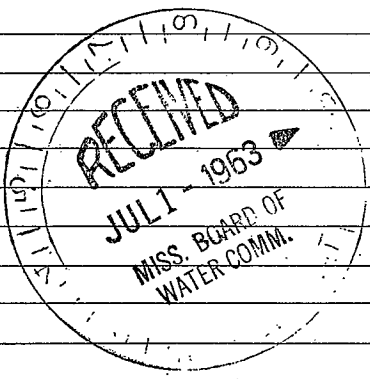

If YES depth of formation \_\_\_\_\_

Why \_\_\_\_\_

Drillers Remarks: \_\_\_\_\_

(Use Back Side)

Well No.

