

6-25-63

WATER WELL DRILLERS LOG

Date June 25, 1963, Driller Porter Drilling & Log Co. Wayne


(1) Owner of Land: Floyd Mc Cormick  
 (Name)  
Rt 3 Waynesboro  
 (Address)  
 (2) Location: NW 1/4, NW 1/4, Sec. 19 T8 R 2  
7 miles west of Waynesboro  
 (distance) (direction) (Nearest Town)  
 (3) Topography: hilly  
 (Hilly) (Flat) (Level)  
 (4) Purpose of Well: water dogs  
 (Domestic Irrigation, Municipal, Industrial, Other)

Description & Color of Materials Sand, Clay, Red Clay, Shell, etc.	Thick- ness Feet	Depth Feet
red clay	18	18
chalk	119	127
clean fine sand	18	145
sand & some chalk	35	180
soft blue chalk & sand	8	188
firm clean blue sand	7	195
blue chalk	44	239
fine blue sand	5	244
thin rock		244
stratified rock & chalk	36	280
green chalk	21	301
fine sand	2	303
blue chalk	66	369
reduced hole at 370'		
limestone rock	23	392
with chalk	8	400

Information upon completion of well:

(1) Diameter 2 inches.  
 (2) Total Depth 400 feet.  
 (3) Water Level 126 feet below top of ground.  
 (4) Cased to 370, Size 2  
Open hole  
 (5) Screen: Size none, Length \_\_\_\_\_  
4" bushing set on rock  
 (6) Were any formations sealed against pollution?  
 \_\_\_\_\_ yes, X no.

If YES depth of formation \_\_\_\_\_  
 Why \_\_\_\_\_  
 Drillers Remarks: \_\_\_\_\_

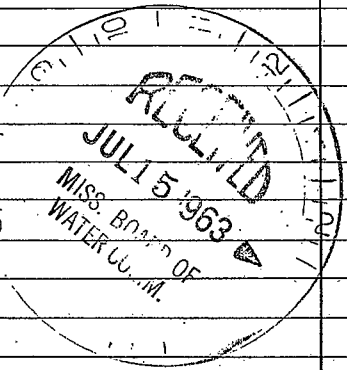

(Use Back Side)

Well No.

