

N 17
5-5-64

WATER WELL DRILLERS LOG

Date: May 5, 1964, Driller: Porter Drilling & Pipe Co. Wayne
(Name)

(1) Owner of Land: John Robert Croley
(Name)
Waynesboro, Miss
(Address)

(2) Location: NW 1/4, NW 1/4, Sec. 14, T8R7
1/2 miles west of Waynesboro
(distance) (direction) (Nearest town)

(3) Topography: flat
(Hilly) (Flat) (Level)

(4) Purpose of Well: domestic
(Domestic Irrigation
Municipal, Industrial, Other)

Description & Color of Materials Sand, Clay, Red Clay, Shell, etc.	Thick- ness Feet	Depth Feet
<u>fine sand</u>	<u>25</u>	<u>25</u>
<u>chalk</u>	<u>3</u>	<u>28</u>
<u>soft rock</u>	<u>3</u>	<u>31</u>
<u>blue chalk</u>	<u>15</u>	<u>46</u>
<u>rock strata</u>	<u>7</u>	<u>53</u>
<u>blue chalk</u>	<u>10</u>	<u>63</u>
<u>hard rock</u>	<u>5</u>	<u>68</u>
<u>blue chalk</u>	<u>63</u>	<u>131</u>
<u>hard rock</u>	<u>30</u>	<u>161</u>
<u>stopped on rock</u>		

Information upon completion of well:

(1) Diameter 2" inches.

(2) Total Depth 161 feet.

(3) Water Level 4' feet below top of ground.

(4) Cased to 131', Size 78' 2 1/2",
53' 2"


(5) Screen: Size none, Length Open hole

(6) Were any formations sealed against pollution?
no yes, X no.

If YES depth of formation _____

Why _____

Drillers Remarks: Vx
Jet 1/2 HP

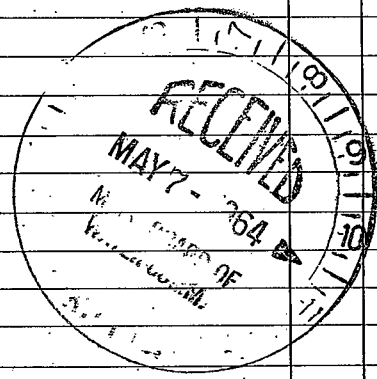

(Use Back Side)

Well No.

