

WAYNE MISSISSIPPI BOARD OF WATER COMMISSIONERS

N18

9-26-63

WATER WELL DRILLERS LOG

Date: Sept. 26, 1963, Driller: Porter Drilling & Supply County: Wayne
 (Name)

(1) Owner of Land: Roland Arnold
 (Name)
Rt 3 Waynesboro, Miss
 (Address)
 (2) Location: NW 1/4, SW 1/4, Sec. 3 T8R7
2 miles west of Waynesboro
 (distance) (direction) (Nearest Town)
 (3) Topography: Hilly
 (Hilly) (Flat) (Level)
 (4) Purpose of Well: domestic
 (Domestic Irrigation, Municipal, Industrial, Other)


| Description & Color of Materials Sand, Clay, Red Clay, Shell, etc. | Thick- ness Feet | Depth Feet |
|---|------------------------|---------------|
| <u>red clay</u> | <u>10</u> | <u>10</u> |
| <u>course sand</u> | <u>30</u> | <u>40</u> |
| <u>sand & chalk</u> | <u>30</u> | <u>70</u> |
| <u>course sand</u> | <u>3</u> | <u>73</u> |
| <u>sand & chalk</u> | <u>5</u> | <u>78</u> |
| <u>med. clean sand</u> | <u>17</u> | <u>95</u> |
| <u>course blue sand</u> | | |
| <u>mixed with chalk</u> | | |
| <u>would not produce</u> | | |
| <u>water</u> | <u>8</u> | <u>103</u> |
| <u>stayed on blue chalk</u> | | |

Information upon completion of well:

(1) Diameter 2" inches.
 (2) Total Depth 95' feet.
 (3) Water Level 79' feet below top of ground.
 (4) Cased to 84', Size 2"
 (5) Screen: Size 1 1/4", Length 10'
 (6) Were any formations sealed against pollution?
 _____ yes, X no.

If YES depth of formation _____
 Why _____

Drillers Remarks: _____

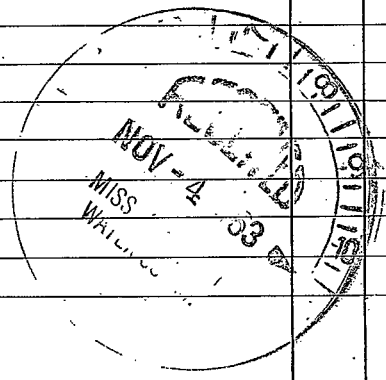

(Use Back Side)

Well No.

54