

WAYNE MISSISSIPPI BOARD OF WATER COMMISSIONERS

N 19
3-3-64

WATER WELL DRILLERS LOG

Date: March 3, 1964, Driller: Porter Drilling Co. County Wayne
(Name)

(1) Owner of Land Chadway Jones
(Name)
Rt. 3 Haysboro
(Address)
(2) Location: SE 1/4, SE 1/4, Sec. 19 T8R7
8 miles S.W, of Haysboro
(distance) (direction) (Nearest Town)
(3) Topography: hilly
(Hilly) (Flat) (Level)
(4) Purpose of Well: domestic
(Domestic Irrigation
Municipal, Industrial, Other)


Description & Color of Materials Sand, Clay, Red Clay, Shell, etc.	Thick- ness Feet	Depth Feet
<u>clay</u>	<u>5</u>	<u>5</u>
<u>chalk</u>	<u>15</u>	<u>20</u>
<u>sand & chalk</u>	<u>15</u>	<u>65</u>
<u>sand</u>	<u>15</u>	<u>80</u>
<u>stopped on chalk</u>		

Information upon completion of well:

(1) Diameter 2" inches.
(2) Total Depth 80' feet.
(3) Water Level 45' feet below top of ground.
(4) Cased to 74', Size 2"
(5) Screen: Size 1 1/4", Length 5'
Johnson S.S.
(6) Were any formations sealed against pollution?
_____ yes, X no.

If YES depth of formation _____
Why _____

Drillers Remarks: _____

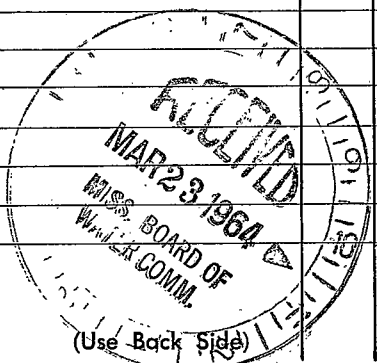

Well No.

