

MISSISSIPPI BOARD OF WATER COMMISSIONERS

WAYNE
N20

WATER WELL DRILLERS LOG

Date: June 27, 1963, Driller: Porter Drilling Co County Wayne
(Name)


(1) Owner of Land: Laurence Jones
(Name)
At 3 Waynesboro, Miss
(Address)
(2) Location: SW 1/4, NE 1/4, Sec. 30 T.8 R.7,
8 miles S.W., of Waynesboro,
(distance) (direction) (Nearest Town)
(3) Topography: hilly
(Hilly) (Flat) (Level)
(4) Purpose of Well: domestic
(Domestic Irrigation
Municipal, Industrial, Other)

Description & Color of Materials Sand, Clay, Red Clay, Shell, etc.	Thick- ness Feet	Depth Feet
<u>red clay</u>	<u>15</u>	<u>15</u>
<u>red sand</u>	<u>13</u>	<u>28</u>
<u>chalk</u>	<u>8</u>	<u>36</u>
<u>tight coarse sand</u>	<u>8</u>	<u>44</u>
<u>loose sand</u>	<u>10</u>	<u>54</u>
<u>tight clean sand</u>	<u>5</u>	<u>59</u>
<u>fine</u>		

Information upon completion of well:

(1) Diameter 2" inches.
(2) Total Depth 59' feet.
(3) Water Level 38' feet below top of ground.
(4) Cased to 54, Size 2"
(5) Screen: Size 1 1/4, Length 5'
Johnson S.S.
(6) Were any formations sealed against pollution?
no.

If YES depth of formation _____
Why _____
Drillers Remarks: _____

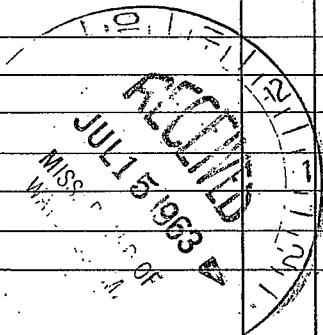

(Use Back Side)

Well No.

June 27 1933
Porter Building
Wash

James Jones

213 Washington St
Wash

1200000
1000000
1000000
30 8 7
2M NE
2M
fine

Wash

21
23

24
2
2.2

X