

N21

6-13-63

WATER WELL DRILLERS LOG

Date: June 13, 1963, Driller: Porter Drilling & Supply Co. Wayne
(Name)

(1) Owner of Land: Zeland Mc Michael
(Name)
At 3 Waynesboro, Miss
(Address)

(2) Location: NE 1/4, NE 1/4, Sec. 7 T8R7
6 miles west of Waynesboro
(distance) (direction) (Nearest Town)

(3) Topography: hilly
(Hilly) (Flat) (Level)


(4) Purpose of Well: domestic
(Domestic Irrigation
 Municipal, Industrial, Other)

Description & Color of Materials Sand, Clay, Red Clay, Shell, etc.	Thick- ness Feet	Depth Feet
<u>red clay</u>	<u>8</u>	<u>8</u>
<u>red sand</u>	<u>13</u>	<u>21</u>
<u>chalk & sand</u>	<u>11</u>	<u>32</u>
<u>yellow sand</u>	<u>26</u>	<u>58</u>
<u>white sand</u>	<u>11</u>	<u>69</u>

Information upon completion of well:

(1) Diameter 2 inches,
 (2) Total Depth 69 feet.
 (3) Water Level 56 feet below top of ground.
 (4) Cased to 63, Size 2
 (5) Screen: Size 1 1/4, Length 6
80 ga
 (6) Were any formations sealed against pollution?
 _____ yes, X no.

If YES depth of formation _____
 Why _____
 Drillers Remarks: _____

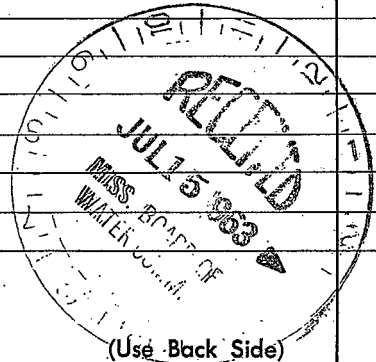

Well No.

