

WAYNE MISSISSIPPI BOARD OF WATER COMMISSIONERS

N 22

5-13-63

WATER WELL DRILLERS LOG

Date: May 13, 1963, Driller Center Drilling & Supply Co. County Wayne
 (Name)

- (1) Owner of Land: Cecil Davis
 (Name)
At 3 Haynesboro, Miss
 Address
- (2) Location: NW 1/4, NW 1/4, Sec 32 T8 R 7
3 miles north of Clava
 (distance) (direction) (Nearest Town)
- (3) Topography: hilly
 (Hilly) (Flat) (Level)
- (4) Purpose of Well: domestic
 (Domestic Irrigation
 Municipal, Industrial, Other)

Description & Color of Materials Sand, Clay, Red Clay, Shell, etc.	Thick- ness Feet	Depth Feet
<u>red clay</u>	<u>12</u>	<u>12</u>
<u>sand</u>	<u>8</u>	<u>20</u>
<u>chalk</u>	<u>26</u>	<u>46</u>
<u>tight low producing sand</u>	<u>12</u>	<u>58</u>


Information upon completion of well:

- (1) Diameter 2' inches.
- (2) Total Depth 58' feet.
- (3) Water Level 26' feet below top of ground.
- (4) Cased to 48', Size 2'
- (5) Screen: Size 1/4, Length 10'
- (6) Were any formations sealed against pollution?
 _____ yes, X no.

If YES depth of formation _____

Why _____

Drillers Remarks: _____

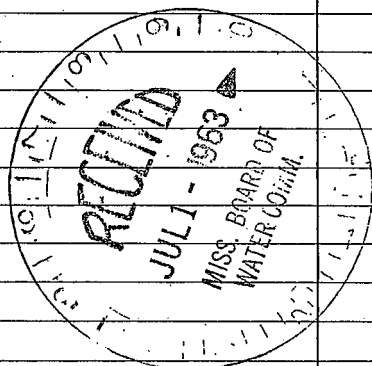

(Use Back Side)

Well No.

