

WAYNE MISSISSIPPI BOARD OF WATER COMMISSIONERS

N 23

4-23-63

WATER WELL DRILLERS LOG

Date: April 23, 1963, Driller: Porter Drilling Co. Wayne
(Name)

(1) Owner of Land: Lana Clark
(Name)
Rt 3 Hagnestown
(Address)

(2) Location: SE 1/4, NW 1/4, Sec. 5 T. 8 R. 7
4 miles west of Hagnestown
(distance) (direction) (Nearest Town)

(3) Topography: Hilly
(Hilly) (Flat) (Level)

(4) Purpose of Well: domestic
(Domestic Irrigation
Municipal, Industrial, Other)

Description & Color of Materials Sand, Clay, Red Clay, Shell, etc.	Thick-ness Feet	Depth Feet
<u>red clay & chert</u>	<u>21</u>	<u>21</u>
<u>sand</u>	<u>27</u>	<u>48</u>
<u>stopped on red sand</u>		

Information upon completion of well:

(1) Diameter 2" inches.


(2) Total Depth 48 feet.

(3) Water Level 28 feet below top of ground.

(4) Cased to 42, Size 2"

(5) Screen: Size 1 1/4, Length 6'
60 ga

(6) Were any formations sealed against pollution?
no

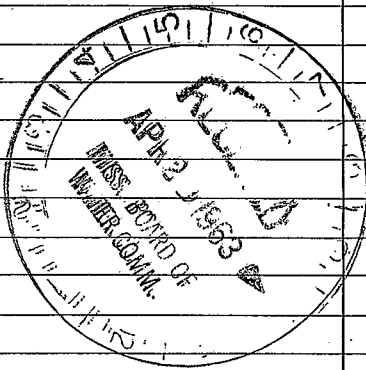

If YES depth of formation _____

Why _____

Drillers Remarks: _____

(Use Back Side)

Well No.

