

N24

9-27-62

WATER WELL DRILLERS LOG

Date: Sept 27, 1962, Driller: Barton Drilling & Log Co., Wayne County, Wayne

(Name)

(1) Owner of Land:	Description & Color of Materials Sand, Clay, Red Clay, Shell, etc.	Thick- ness Feet	Depth Feet
John Emgey (Name)	red clay	10	10
Pt. 4 Waynesboro, Miss (Address)	sand	5	15
(2) Location: NE 1/4, NE 1/4, Sec. 1 T8R7	red. chalk	15	30
1/4 miles N of Waynesboro (distance) (direction) (Nearest Town)	blue chalk	19	49
(3) Topography: hilly (Hilly) (Flat) (Level)	strata's rock & blue chalk	22	71
(4) Purpose of Well: domestic (Domestic Irrigation Municipal, Industrial, Other)	grey sand	20	91
	stippled white stellan sand		


Information upon completion of well:

- (1) Diameter 2" inches.
- (2) Total Depth 91' feet.
- (3) Water Level 74' feet below top of ground.
- (4) Cased to 84', Size 2"
- (5) Screen: Size 1 1/4", Length 6'
- (6) Were any formations sealed against pollution?  
 yes,  no.

If YES depth of formation \_\_\_\_\_

Why \_\_\_\_\_

Drillers Remarks: \_\_\_\_\_

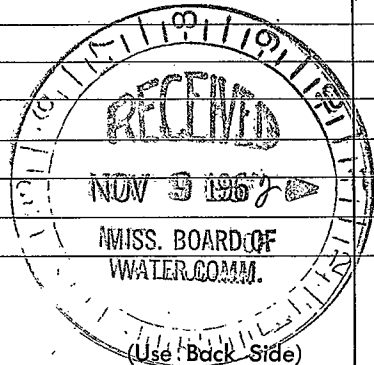

Well No.

12.43