

Wayne
 N25
 1-67

MISSISSIPPI
 BOARD OF WATER COMMISSIONERS
 416 North State Street
 Jackson, Mississippi 39201

WATER WELL DRILLERS LOG

Jan 27 1967 Porter Drilling & Log Wayne
 date well completed firm name county well located

LANDOWNER:
Dr. L. Busby
Rt 1 Waynesboro Miss
 (mailing address)


description of formations encountered	from	to
	red clay & sand	0
sand	8	20
stopped on rock		

WELL LOCATION:
 sec. 1 T 8 N R 7 E
 S W
1/4 miles NW of Waynesboro
 (distance) (direction) (nearest town)

WELL PURPOSE: unknown
 (home, irrigation, municipal, industrial)


- WELL COMPLETION DATA:
- (1) diameter (inches) 1 1/4
 - (2) total depth (feet) 20
 - (3) static water level (feet) 10 below above top of ground.
 - (4) casing galv. steel, 17'
 (material) (depth)
1 1/4" if telescope see back.
 (size)
 - (5) screen 3', 17
 (length) (depth to top)
1 1/4, Johnson S&H SS.
 (size) (material)
 - (6) pump 2, 8
 (HP) (yield gpm)
elec
 (type power)
 - (7) electric log no
 (yes or no)
 (organization running log)
 - (8) how well bottom plugged 1 1/4 galv

DRILLERS REMARKS:

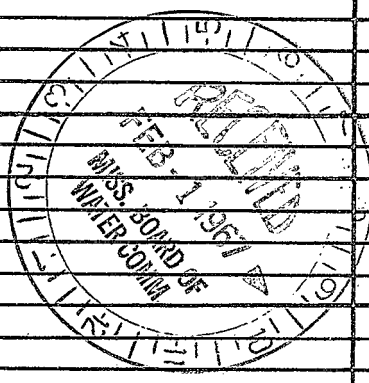

If well telescopes please sketch and show depths.

GROUND LEVEL

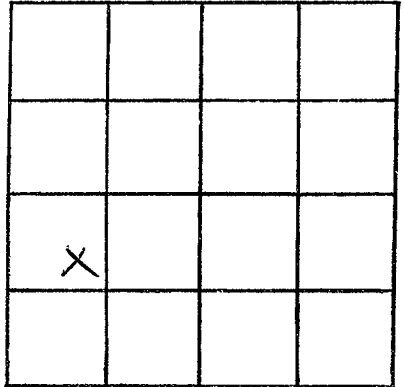

SECTION 1

Please indicate well location X.

ADDITIONAL INFORMATION

If more than one screen,
show locations of each on sketch.