

WAYNE

MISSISSIPPI BOARD OF WATER COMMISSIONERS

N 26

12-1-65

WATER WELL DRILLERS LOG

Date: Dec 1, 1965, Driller: Porter Drilling & Pump Co. County: Wayne

(1) Owner of Land: J. L. Martin Jr.
 (Name)
Waynesboro, Miss
 (Address)

(2) Location: NW 1/4, NE 1/4, Sec. 1 T8R7
1 miles N of Waynesboro
 (distance) (direction) (Nearest Town)

(3) Topography: hilly
 (Hilly) (Flat) (Level)

(4) Purpose of Well: domestic
 (Domestic Irrigation
 Municipal, Industrial, Other)

Description & Color of Materials Sand, Clay, Red Clay, Shell, etc.	Thick- ness Feet	Depth Feet
<u>red clay & sand</u>	<u>10</u>	<u>10</u>
<u>blue chalk</u>	<u>6</u>	<u>16</u>
<u>thin rock</u>		<u>16</u>
<u>blue chalk</u>	<u>6</u>	<u>22</u>
<u>rock strata</u>	<u>21</u>	<u>43</u>
<u>Chalk</u>	<u>2</u>	<u>45</u>
<u>course blue sand</u>	<u>14</u>	<u>59</u>
<u>blue chalk</u>	<u>20</u>	<u>79</u>
<u>rock strata</u>	<u>4</u>	<u>83</u>
<u>soft shale</u>	<u>2</u>	<u>85</u>
<u>homogeneous rock</u>	<u>27</u>	<u>112</u>

Information upon completion of well:

(1) Diameter 2' inches.

(2) Total Depth 112' feet.

(3) Water Level 54' feet below top of ground.

(4) Cased to 88', Size 2"


(5) Screen: Size none, Length _____

(6) Were any formations sealed against pollution?
 _____ yes, no.

If YES depth of formation _____

Why _____

Drillers Remarks: _____

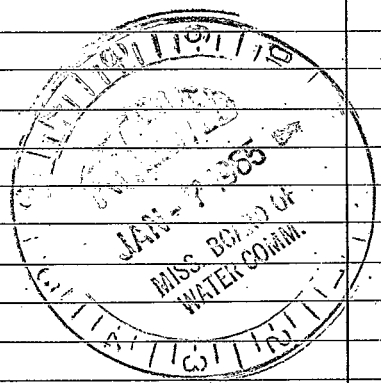

(Use Back Side)

Well No.

