

WAYNE MISSISSIPPI BOARD OF WATER COMMISSIONERS

N 27

1-28-66

WATER WELL DRILLERS LOG

Date: Jan 28, 1966, Driller: Porter Dilling's Sup County, Wayne
 (Name)

(1) Owner of Land: <u>Cecil Walker</u> (Name)	Description & Color of Materials Sand, Clay, Red Clay, Shell, etc.	Thick- ness Feet	Depth Feet
<u>Rt 1 Waynesboro, Miss</u> (Address)	<u>sandy soil</u>	<u>12</u>	<u>12</u>
(2) Location: <u>NW 1/4, NW 1/4, Sec. 2 T 8 R 7</u>	<u>chalk</u>	<u>10</u>	<u>22</u>
<u>1 1/2</u> miles <u>NW</u> , of <u>Waynesboro</u> (distance) (direction) (Nearest Town)	<u>sand</u>	<u>7</u>	<u>29</u>
(3) Topography: <u>flat</u> (Hilly) (Flat) (Level)	<u>stagnant or chalk</u>		
(4) Purpose of Well: <u>domestic</u> (Domestic Irrigation Municipal, Industrial, Other)			


Information upon completion of well:

- (1) Diameter 2" inches.
- (2) Total Depth 29' feet.
- (3) Water Level 13' feet below top of ground.
- (4) Cased to 23', Size 2"
- (5) Screen: Size 1 1/4", Length 6'
60 ga.
- (6) Were any formations sealed against pollution?
 yes, no.

If YES depth of formation _____

Why _____

Drillers Remarks: _____

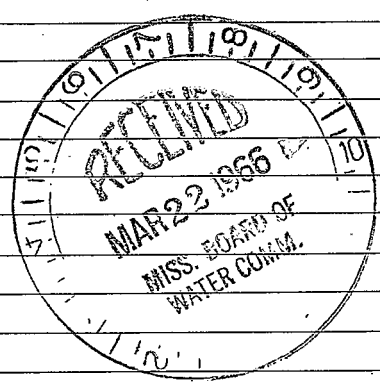

(Use Back Side)

Well No.

