


N 30

7-27-62

WATER WELL DRILLERS LOG

Date: July 27, 1962, Driller: Porter Drilling & Log County Wayne  
 (Name)

(1) Owner of Land:	Description & Color of Materials Sand, Clay, Red Clay, Shell, etc.	Thick- ness Feet	Depth Feet
(Name) <u>J. C. Martin Lumber Co.</u> (Address) <u>Waynesboro, Miss.</u>	<u>crawfish clay</u>	<u>12</u>	<u>12</u>
(2) Location: <u>SW 1/4, NE 1/4, Sec. 2 T. 8R. 7,</u>	<u>sand</u>	<u>8</u>	<u>20</u>
<u>1/2</u> miles <u>NW</u> of <u>Waynesboro</u> (distance) (direction) (Nearest Town)	<u>blue chalk</u>	<u>2</u>	<u>22</u>
(3) Topography: <u>flat</u> (Hill) (Flat) (Level)	<u>lime rock</u>	<u>8</u>	<u>30</u>
(4) Purpose of Well: <u>Industrial</u> (Domestic Irrigation Municipal, Industrial, Other)	<u>blue chalk</u>	<u>39</u>	<u>69</u>
Information upon completion of well:	<u>lime core rock</u>	<u>3</u>	<u>72</u>
(1) Diameter <u>4"</u> inches.	<u>blue chalk</u>	<u>2</u>	<u>74</u>
(2) Total Depth <u>164</u> feet.	<u>lime rock</u>	<u>1</u>	<u>75</u>
(3) Water Level <u>43</u> feet below top of ground.	<u>blue chalk</u>	<u>14</u>	<u>89</u>
(4) Cased to <u>89'</u> , Size <u>4"</u>	<u>lime core rock</u>	<u>8</u>	<u>97</u>
(5) Screen: Size <u>none</u> Length _____	<u>chalk &amp; shale</u>	<u>18</u>	<u>115</u>
(6) Were any formations sealed against pollution? <u>X</u> yes, _____ no.	<u>shale &amp; blue sand</u>	<u>9</u>	<u>124</u>
If YES depth of formation <u>4" casing</u>	<u>sand &amp; shale</u>	<u>22</u>	<u>146</u>
Why <u>set on rocks</u>	<u>blue chalk</u>	<u>18</u>	<u>164</u>
Drillers Remarks: <u>at 89'</u>			
<u>open hole below</u>			

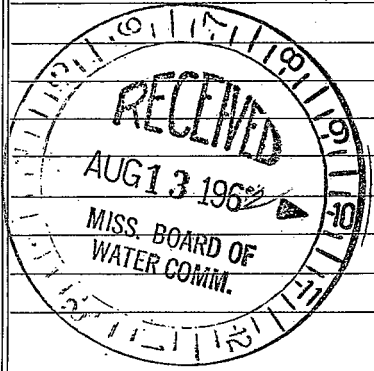

(Use Back Side)

Well No.

