

WAYNE
N 31

MISSISSIPPI BOARD OF WATER COMMISSIONERS

N 307

7-17-61

WATER WELL DRILLERS LOG

Date: July 17, 1961, Driller: D. N. Porter Low County, Wayne
(Name)


(1) Owner of Land:	Description & Color of Materials Sand, Clay, Red Clay, Shell, etc.	Thick- ness Feet	Depth Feet
<u>Pat Powell</u> (Name)	<u>clay</u>	<u>10</u>	<u>10</u>
<u>Rt 1 Haynesboro, Miss.</u> (Address)	<u>sand</u>	<u>26</u>	<u>36</u>
(2) Location: <u>SE 1/4, NW 1/4, Sec. 3 T8R7</u>	<u>chalk</u>	<u>54</u>	<u>90</u>
<u>2</u> miles <u>NW</u> of <u>Haynesboro</u>	<u>lime rock</u>	<u>44</u>	<u>134</u>
(distance). (direction) (Nearest Town)	<u>blue chalk s</u>	<u>50</u>	<u>184</u>
(3) Topography: <u>hilly</u>	<u>lime rock</u>		<u>184</u>
(Hilly) (Flat) (Level)	<u>honeycomb rock</u>	<u>36</u>	<u>220</u>
(4) Purpose of Well: <u>domestic</u>	<u>sand chalk</u>	<u>10</u>	<u>230</u>
(Domestic Irrigation Municipal, Industrial, Other)			

Information upon completion of well:

- (1) Diameter 2" inches.
- (2) Total Depth 230' feet.
- (3) Water Level 130' feet below top of ground.
- (4) Cased to 184', Size 2"
- (5) Screen: Size no screen, Length _____
- (6) Were any formations sealed against pollution?
X yes, _____ no.

seal off with 3' collar at
If YES depth of formation 184

Why rest of hole open in
honeycomb rock
Drillers Remarks:

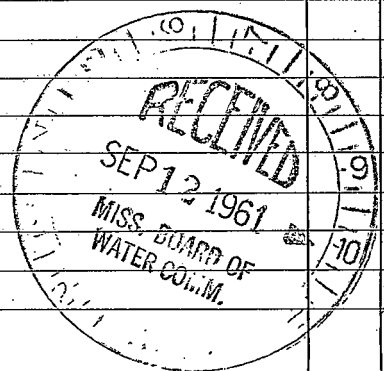

(Use Back Side)

Well No.

