

WAYNE
N 34
5-4-61

MISSISSIPPI BOARD OF WATER COMMISSIONERS

WATER WELL DRILLERS LOG

M 303

Date: May 4, 1961, Driller: D. N. Porter & Son County Wayne
(Name)

(1) Owner of Land: E. B. Davis
(Name)
211 Magneshoro, Miss.
(Address)

(2) Location: NE 1/4, NE 1/4, Sec. 3 T. 8 R. 7
1 miles NW of Magneshoro
(distance) (direction) (Nearest Town)

(3) Topography: flat
(Hilly) (Flat) (Level)

(4) Purpose of Well: domestic
(Domestic Irrigation
Municipal, Industrial, Other)

Description & Color of Materials Sand, Clay, Red Clay, Shell, etc.	Thick- ness Feet	Depth Feet
<u>clay</u>	<u>15</u>	<u>15'</u>
<u>sand</u>	<u>12</u>	<u>27'</u>

Information upon completion of well:

(1) Diameter 1 1/4" inches.

(2) Total Depth 27' feet.

(3) Water Level 15' feet below top of ground.

(4) Cased to 21', Size 1 1/4"


(5) Screen: Size 1 1/4", Length 6'

(6) Were any formations sealed against pollution?
_____ yes, X no.

If YES depth of formation _____

Why _____

Drillers Remarks: _____

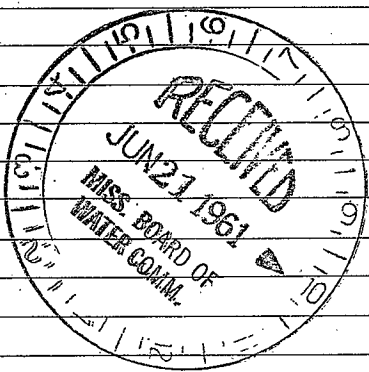

(Use Back Side)

Well No.

