

WAYNE MISSISSIPPI BOARD OF WATER COMMISSIONERS

N 37

3-7-63

WATER WELL DRILLERS LOG


Date: March 7, 1963, Driller: Porter Drilling & Log County Wayne
 (Name)

(1) Owner of Land: Shad Clark
 (Name)
Rt 3 Waynesboro, Miss
 (Address)
 (2) Location: NW 1/4, NW 1/4, Sec. 5 T 8 R 7
5 miles west of Waynesboro
 (distance) (direction) (Nearest Town)
 (3) Topography: Hilly
 (Hilly) (Flat) (Level)
 (4) Purpose of Well: domestic
 (Domestic Irrigation
 Municipal, Industrial, Other)

Description & Color of Materials Sand, Clay, Red Clay, Shell, etc.	Thick- ness Feet	Depth Feet
<u>red clay</u>	<u>8</u>	<u>8</u>
<u>chalk & sand mixed</u>	<u>52</u>	<u>60</u>
<u>sand & some chalk</u>	<u>15</u>	<u>75</u>
<u>chalk & sand</u>	<u>2</u>	<u>77</u>

Information upon completion of well:

(1) Diameter 2' inches.
 (2) Total Depth 75' feet.
 (3) Water Level 36' feet below top of ground.
 (4) Cased to 69', Size 2"
 (5) Screen: Size 1 1/4", Length 6'
60 ga.
 (6) Were any formations sealed against pollution?
 _____ yes, X no.

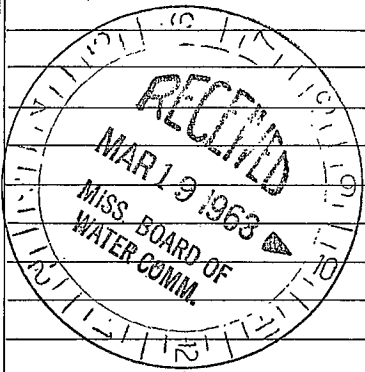

If YES depth of formation _____
 Why _____
 Drillers Remarks: _____

(Use Back Side)

Well No.

