

WAYNE

MISSISSIPPI BOARD OF WATER COMMISSIONERS

N41

4-22-61

WATER WELL DRILLERS LOG

M 300

Date April 22, 1961, Driller J. N. Porterson County Wayne
(Name)

(1) Owner of Land: <u>Jim Mozingo</u> (Name)	Description & Color of Materials Sand, Clay, Red Clay, Shell, etc.	Thick- ness Feet	Depth Feet
<u>At 1 Waynesboro</u> (Address)	<u>clay</u>	<u>15'</u>	<u>15'</u>
(2) Location <u>SE 1/4, NW 1/4, Sec. 6 T.8.R.7</u>	<u>sand & chalk</u>	<u>30'</u>	<u>45'</u>
<u>2 miles west</u> of <u>Waynesboro</u> (distance) (direction) (Nearest Town)	<u>sand & fine gravel</u>	<u>123</u>	<u>168'</u>
(3) Topography: <u>hilly</u> (Hilly) (Flat) (Level)	<u>strip of chalk</u>		
(4) Purpose of Well: <u>oil well drilling</u> (Domestic Irrigation Municipal, Industrial, Other)			


Information upon completion of well:

- (1) Diameter 4" inches.
- (2) Total Depth 168 feet.
- (3) Water level 85' feet below top of ground.
- (4) Cased to 147, Size 4"
- (5) Screen: Size 4", Length 21'
slotted 4" pipe
- (6) Were any formations sealed against pollution?
no

If YES depth of formation _____

Why _____

Drillers Remarks: _____

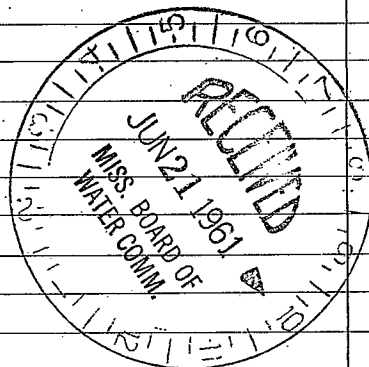

(Use Back Side)

Well No.

