

Wayne
N 43
4-67

**MISSISSIPPI  
BOARD OF WATER COMMISSIONERS**  
416 North State Street  
Jackson, Mississippi 39201

**WATER WELL DRILLERS LOG**

<u>April 25</u> <small>date well completed</small>	<u>1967 Porter Drilling Corp</u> <small>firm name</small>	<u>Wayne</u> <small>county well located</small>
---	--	--

**LANDOWNER:** Alvin Troy Sanderson

**WELL LOCATION:**  
 Pt 3 Waynesboro  
(mailing address)

**WELL PURPOSE:** home  
(home, irrigation, municipal, industrial)

description of formations encountered	from	to
<u>red clay</u>	0	10
<u>red chalk</u>	10	25
<u>blue chalk</u>	25	76
<u>fluffy sand &amp; chalk</u>	76	119
<u>firm white sand</u>	119	126
<u>strapped on red sand</u>		
<u>circulation lost drilling at 112'</u>		

**WELL COMPLETION DATA:**

(1) diameter (inches) 2"

(2) total depth (feet) 126'

(3) static water level (feet) 42' below above top of ground.

(4) casing steel, 120'  
(material) (depth)  
2" if telescope see back.  
(size)


(5) screen 5', 121'  
(length) (depth to top)  
1/4", Johnson S.S.  
(size) (material)

(6) pump 3/4, 8  
(HP) (yield gpm)  
elec  
(type power)

(7) electric log no  
(yes or no)  
(organization running log)

(8) how well bottom plugged flush ground


7 slot with 1/2" x 1/4" log pipe  
test in with guake

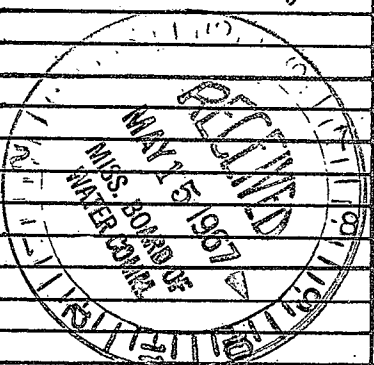

**DRILLERS REMARKS:**

If well telescopes please sketch and show depths.

GROUND LEVEL

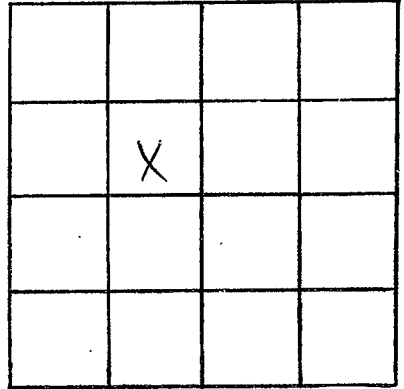

SECTION 7

Please indicate well location X.

ADDITIONAL INFORMATION

If more than one screen, show locations of each on sketch.