

WAYNE MISSISSIPPI BOARD OF WATER COMMISSIONERS

N45

4-25-65

WATER WELL DRILLERS LOG

Date April 25, 1965, Driller: Porter Drilling Co. County Wayne
 (Name)

(1) Owner of Land: R. L. Lynch
 (Name)
Lavel, Miss
 (Address)

(2) Location: SW 1/4, SE 1/4, Sec. 8 T8R7
1/4 miles west of Waynesboro
 (distance) (direction) (Nearest Town)

(3) Topography: Hilly
 (Hilly) (Flat) (Level)

(4) Purpose of Well: hog farm
 (Domestic Irrigation
 Municipal, Industrial, Other)

Description & Color of Materials Sand, Clay, Red Clay, Shell, etc.	Thick- ness Feet	Depth Feet
<u>red clay</u>	<u>4</u>	<u>4</u>
<u>thin rock</u>	<u>4</u>	<u>4</u>
<u>sand</u>	<u>4</u>	<u>8</u>
<u>thin rock</u>		<u>8</u>
<u>Chalk</u>	<u>14</u>	<u>22</u>
<u>sand</u>	<u>5</u>	<u>27</u>
<u>Chalk</u>	<u>51</u>	<u>78</u>
<u>loose sand</u>	<u>14</u>	<u>92</u>
<u>firm sand</u>	<u>13</u>	<u>105</u>
<u>course red sand</u>	<u>7</u>	<u>112</u>
<u>course white sand</u>	<u>4</u>	<u>116</u>
<u>course loose sand</u> <u>& Chalk</u>	<u>4</u>	<u>120</u>

Information upon completion of well:

(1) Diameter 4" inches.

(2) Total Depth 120' feet.


(3) Water Level 66' feet below top of ground.

(4) Cased to 105', Size 4"

(5) Screen: Size 3 1/4", Length 10'
Johnson S.S.

(6) Were any formations sealed against pollution?
 _____ yes, X no.

If YES depth of formation _____
 Why _____
 Drillers Remarks: _____

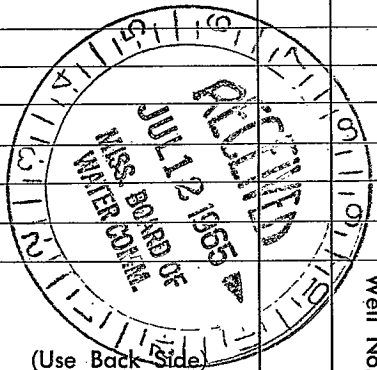

Well No. _____

(Use Back Side)

