

N46

11-4-61

WATER WELL DRILLERS LOG

N

Date: Nov 4, 1961, Driller: D. N. Porter Wade County Wayne  
 (Name)


(1) Owner of Land: <u>R. L. Lynch</u> (Name)	Description & Color of Materials Sand, Clay, Red Clay, Shell, etc.	Thick- ness Feet	Depth Feet
<u>Rt 3 Waynesboro</u> (Address)	<u>Clay 1'</u>	<u>18</u>	<u>18'</u>
(2) Location: <u>SW 1/4, SE 1/4, Sec. 8 T.8.R.7</u>	<u>Chalk</u>	<u>72</u>	<u>90</u>
<u>3</u> miles <u>west</u> of <u>Waynesboro</u> (distance) (direction) (Nearest Town)	<u>fine sand</u>	<u>8</u>	<u>98</u>
(3) Topography: <u>hilly</u> (Hilly) (Flat) (Level)	<u>loose cavity formation</u>	<u>4</u>	<u>102</u>
(4) Purpose of Well: <u>domestic</u> (Domestic Irrigation Municipal, Industrial, Other)	<u>fine sand</u>	<u>8</u>	<u>110</u>
	<u>course sand</u>	<u>9</u>	<u>119</u>
	<u>stopped on chalk</u>		

Information upon completion of well:

- (1) Diameter 2" inches.
- (2) Total Depth 119' feet.
- (3) Water Level 68' feet below top of ground.
- (4) Cased to 113', Size 2".
- (5) Screen: Size 1/4", Length 6'.
- (6) Were any formations sealed against pollution?  
 yes,  no.

If YES depth of formation \_\_\_\_\_  
 Why \_\_\_\_\_

Drillers Remarks: \_\_\_\_\_

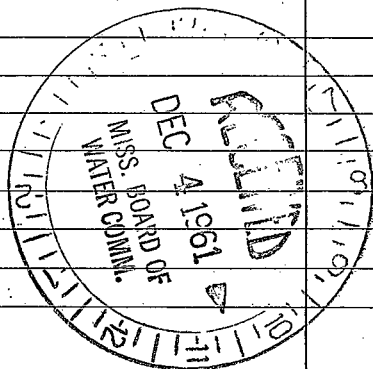

(Use Back Side)

Well No.

