

N48

7-4-62

WATER WELL DRILLERS LOG

Date: July 4, 1962, Driller: Porter Drilling & Svc County Wayne
 (Name)

(1) Owner of Land: <u>Marrin Hall</u>	Description & Color of Materials Sand, Clay, Red Clay, Shell, etc.	Thick-ness Feet	Depth Feet
(Name)	<u>crawfish clay</u>	<u>12</u>	<u>12</u>
<u>Plot 3 Haynesboro</u>	<u>sand</u>	<u>8</u>	<u>20</u>
(Address)	<u>blue chalk</u>	<u>6</u>	<u>26</u>
(2) Location: <u>NW 1/4, NE 1/4, Sec. 10 T. 8 R. 7</u>	<u>strata of lime rock & chert</u>	<u>29</u>	<u>55</u>
<u>1</u> miles <u>west</u> of <u>Haynesboro</u>	<u>blue chalk</u>	<u>45</u>	<u>100</u>
(distance) (direction) (Nearest Town)	<u>honeycom rock</u>	<u>30</u>	<u>130</u>
(3) Topography: <u>flat</u>	<u>white chert & rock</u>	<u>12</u>	<u>142</u>
(Hills) (Flat) (Level)			
(4) Purpose of Well: <u>domestic</u>			
(Domestic Irrigation Municipal, Industrial, Other)			

Information upon completion of well:


- (1) Diameter 2' inches.
- (2) Total Depth 142' feet.
- (3) Water Level 10' feet below top of ground.
- (4) Cased to 100', Size 2"
- (5) Screen: Size none, Length _____
- (6) Were any formations sealed against pollution?

yes, no.

If YES depth of formation sealed at 100'

Why _____

Drillers Remarks: 3 1/2 bush on end of 2' casing set in rock on top of honeycom rock

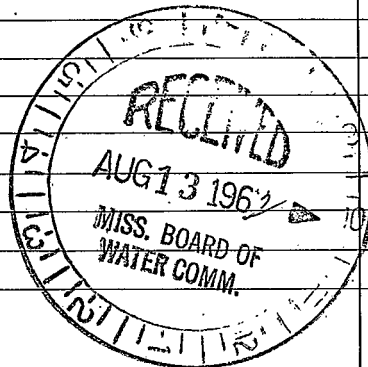

(Use Back Side)

Well No.

