

Wayne
 N 49
 4-67

MISSISSIPPI
 BOARD OF WATER COMMISSIONERS
 416 North State Street
 Jackson, Mississippi 39201

WATER WELL DRILLERS LOG

April 19 1967 Porter Drilling & Pump Wayne
 date well completed firm name county well located

LANDOWNER: John Robert Coley
Spring St

description of formations encountered	from	to
sand	0	8
blue chalk	8	24
rock strata	24	34
blue chalk	34	45
rock	45	47
blue chalk	47	64
soft rock	64	68
blue chalk	68	131
Vicksburg sandstone		
rock	131	161


Waynesboro Miss
 (mailing address)

WELL LOCATION:
 sec. 11 T 8 N R 7 E
S W
1 miles west of Waynesboro
 (distance) (direction) (nearest town)

WELL PURPOSE: home
 (home, irrigation, municipal, industrial)

- WELL COMPLETION DATA:
- (1) diameter (inches) 2"
 - (2) total depth (feet) 161'
 - (3) static water level (feet) 16' below above top of ground.
 - (4) casing steel, 131'
 (material) (depth)
2" if telescope see back.
 (size)
 - (5) screen none, used
 (length) (depth to top)
 (size) (material)
 - (6) pump 1/2 8
 (HP) (yield gpm)
elec
 (type power)
 - (7) electric log no
 (yes or no)
 (organization running log)
 - (8) how well bottom plugged
open ended seal in rock

DRILLERS REMARKS:

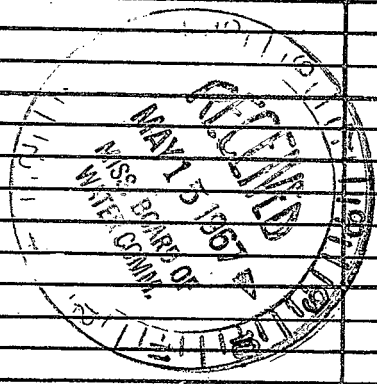

If well telescopes please sketch and show depths.

GROUND LEVEL

	X		

SECTION 11

Please indicate well location X.

ADDITIONAL INFORMATION

If more than one screen,
show locations of each on sketch.