

N50

3-26-63

WATER WELL DRILLERS LOG

Date: March 26, 1963, Driller: Porter Drilling Co. County Wayne
 (Name)


(1) Owner of Land Curtis Mc Michael
 (Name)
At 3 Waynesboro
 (Address)
 (2) Location: NW 1/4, NW 1/4, Sec. 11 T8 R7,
1 miles west, of Waynesboro
 (distance) (direction) (Nearest Town)
 (3) Topography: flat
 (Hilly) (Flat) (Level)
 (4) Purpose of Well: domestic
 (Domestic Irrigation
 Municipal, Industrial, Other)

Description & Color of Materials Sand, Clay, Red Clay, Shell, etc.	Thick- ness Feet	Depth Feet
sand	22	22
strata of lime rock	34	56
blue chert	48	104
limestone rock	31	135
white chert	7	142

Information upon completion of well:

(1) Diameter 2" inches.
 (2) Total Depth 142' feet.
 (3) Water Level 78' feet below top of ground.
 (4) Cased to 105', Size 2"
 (5) Screen: Size _____, Length _____
no screen
 (6) Were any formations sealed against pollution?
 _____ yes, X no.

If YES depth of formation _____
 Why _____
 Drillers Remarks: _____

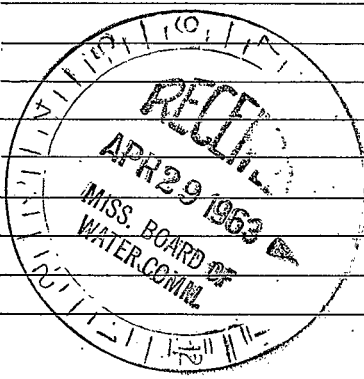

(Use Back Side)

Well No.

