

WAYNE MISSISSIPPI BOARD OF WATER COMMISSIONERS

N 52

3-22-66 WATER WELL DRILLERS LOG

Date: March 22, 1966, Driller: Porter Drilling & Log County: Wayne
 (Name)


(1) Owner of Land: C. H. Graham
 (Name)
Rt 3 Waynesboro, Miss
 (Address)
 (2) Location: SW 1/4, SW 1/4, Sec. 16 T8 R7
4 miles SW of Waynesboro
 (distance) (direction) (Nearest Town)
 (3) Topography: Hilly
 (Hilly) (Flat) (Level)
 (4) Purpose of Well: domestic
 (Domestic Irrigation
 Municipal, Industrial, Other)

| Description & Color of Materials Sand, Clay, Red Clay, Shell, etc. | Thick- ness Feet | Depth Feet |
|---|------------------------|---------------|
| <u>red clay</u> | <u>10</u> | <u>10</u> |
| <u>fine sand & chalk</u> | <u>60</u> | <u>70</u> |
| <u>hard coarse sand</u> | <u>14</u> | <u>84</u> |
| <u>stayed white shell</u> | | |
| <u>in sand</u> | | |

Information upon completion of well:

(1) Diameter 2" inches.
 (2) Total Depth 84' feet.
 (3) Water Level 57' feet below top of ground.
 (4) Cased to 78', Size 2"
 (5) Screen: Size 1 1/4", Length 5'
No 7 slot Johnson S.S.
 (6) Were any formations sealed against pollution?
 _____ yes, X no.

If YES depth of formation _____
 Why _____
 Drillers Remarks: _____

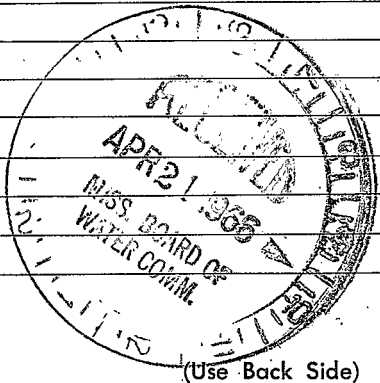

(Use Back Side)

Well No.

