

WAYNE MISSISSIPPI BOARD OF WATER COMMISSIONERS

N 54

5-7-66

WATER WELL DRILLERS LOG

Date: May 7, 1966, Driller: Porter Drilling Co. Wayne
 (Name)

(1) Owner of Land:	Description & Color of Materials Sand, Clay, Red Clay, Shell, etc.	Thick- ness Feet	Depth Feet
Lee's Chapel Baptist Church (Name) Rt 3 Waynesboro, Miss (Address)	red clay red sand chalk & sand	8 24 30	8 32 62
(2) Location: <u>SW 1/4, SE 1/4, Sec. 19 T. 8 R. 7.</u> <u>6</u> miles <u>SW</u> of <u>Waynesboro</u> (distance) (direction) (Nearest Town)	soft fluffy sand stopped on chalk	24	86
(3) Topography: <u>hilly</u> (Hilly) (Flat) (Level)			
(4) Purpose of Well: <u>domestic</u> (Domestic Irrigation Municipal, Industrial, Other)			

Information upon completion of well:


- (1) Diameter 2" inches.
- (2) Total Depth 85' feet.
- (3) Water Level 57' feet below top of ground.
- (4) Cased to 79', Size 2"
- (5) Screen: Size 1 1/4", Length 5'
8 slot Johnson S. S.
- (6) Were any formations sealed against pollution?

yes, no.

If YES depth of formation _____

Why _____

Drillers Remarks: _____

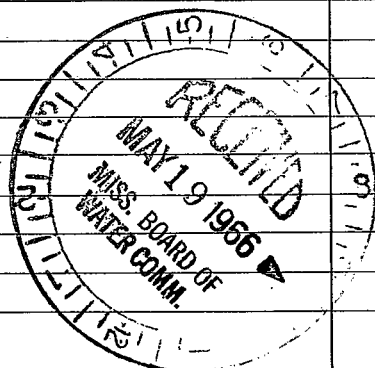

(Use Back Side)

Well No. _____

