

N 56

9-6-64

WATER WELL DRILLERS LOG

Date: Sept 6, 1964, Driller: Porter Drilling & Log Co. County: Wayne

(1) Owner of Land: Steve Lee  
 (Name)  
At 3 Waynesboro Miss  
 (Address)

(2) Location: NE 1/4, NW 1/4, Sec 19 T8 R7  
6 miles SW of Waynesboro  
 (distance) (direction) (Nearest Town)

(3) Topography: hilly  
 (Hilly) (Flat) (Level)

(4) Purpose of Well: domestic  
 (Domestic Irrigation  
 Municipal, Industrial, Other)

Description & Color of Materials Sand, Clay, Red Clay, Shell, etc.	Thick- ness Feet	Depth Feet
red clay	5	5
red chalk	10	15
blue chalk	58	73
fine sand	13	86
chalk	6	92
sand & chalk	33	125
chalk & sand	17	142
clean sand	6	148
sand & chalk	22	170
blue chalk	60	230
rock strata	40	270
brown chalk	20	290
streak of med. sand	10	300
blue chalk	60	360
honeycom rock	25	385
white chalk	5	390

Information upon completion of well:

(1) Diameter 2" inches.

(2) Total Depth 390' feet.

(3) Water Level 126' feet below top of ground.

(4) Cased to 360', Size 2"

(5) Screen: Size none, Length \_\_\_\_\_

(6) Were any formations sealed against pollution?  
 \_\_\_\_\_ yes, X no.


If YES depth of formation \_\_\_\_\_

Why \_\_\_\_\_

Drillers Remarks: \_\_\_\_\_

\_\_\_\_\_

\_\_\_\_\_

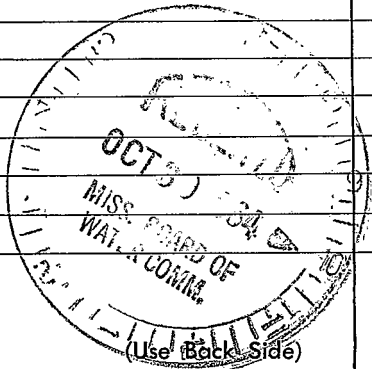

Well No.

