

WAYNE MISSISSIPPI BOARD OF WATER COMMISSIONERS

N57

3-13-63 WATER WELL DRILLERS LOG

Date: March 13, 1963, Driller: Porter Drilling & Pipe Co. Wayne  
(Name)

(1) Owner of Land: Andy Andrews  
(Name)  
Rt 3 Waynesboro  
(Address)

(2) Location: NW 1/4, NW 1/4, Sec 21 T 2 R 7  
4 miles SW of Waynesboro  
(distance) (direction) (Nearest Town)

(3) Topography: Hilly  
(Hilly) (Flat) (Level)

(4) Purpose of Well: domestic  
(Domestic Irrigation Municipal, Industrial, Other)

Description & Color of Materials Sand, Clay, Red Clay, Shell, etc.	Thick- ness Feet	Depth Feet
<u>red clay</u>	<u>12</u>	<u>12</u>
<u>sand &amp; shells</u>	<u>38</u>	<u>50</u>
<u>sand</u>	<u>16</u>	<u>66</u>
<u>chert</u>	<u>1</u>	<u>67</u>

Information upon completion of well:

(1) Diameter 2" inches.


(2) Total Depth 66' feet.

(3) Water Level 52' feet below top of ground.

(4) Cased to 6.3', Size 2"

(5) Screen: Size 2", Length 3'

(6) Were any formations sealed against pollution?  
no, X yes.

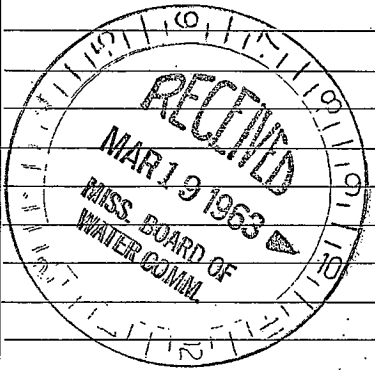

If YES depth of formation \_\_\_\_\_

Why \_\_\_\_\_

Drillers Remarks: \_\_\_\_\_

(Use Back Side)

Well No.

