

Wayne
N 58

MISSISSIPPI BOARD OF WATER COMMISSIONERS

9-66

WATER WELL DRILLERS LOG

Date: Sept 6, 1966, Driller: Porter Drilling Co. County: Wayne
(Name)

(1) Owner of Land: <u>Miss Nat. Guard</u> (Name)	Description & Color of Materials Sand, Clay, Red Clay, Shell, etc.	Thick- ness Feet	Depth Feet
<u>Box 3 Waynesboro, Miss</u> (Address)	<u>sandy soil</u>	<u>8</u>	<u>8</u>
(2) Location: <u>SW 1/4, NE 1/4, Sec. 24, T8R7</u>	<u>Coarse white sand stopped on blue clay</u>	<u>10</u>	<u>18'</u>
<u>1</u> miles <u>south</u> of <u>Waynesboro</u> (distance) (direction) (Nearest Town)			
(3) Topography: <u>level</u> (Hilly) (Flat) (Level)			
(4) Purpose of Well: <u>domestic</u> (Domestic Irrigation Municipal, Industrial, Other)			


Information upon completion of well:

- (1) Diameter 2" inches.
- (2) Total Depth 18' feet.
- (3) Water Level 8' feet below top of ground.
- (4) Cased to 14', Size 2"
- (5) Screen: Size 2", Length 4'
10 slot Johnson S.S.
- (6) Were any formations sealed against pollution?
no

If YES depth of formation _____

Why _____

Drillers Remarks: _____

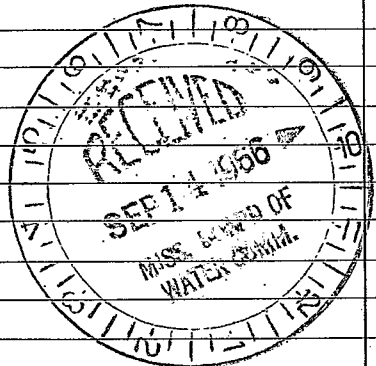

(Use Back Side)

Well No.

