

WAYNE

MISSISSIPPI BOARD OF WATER COMMISSIONERS

N 59

9-2-65

WATER WELL DRILLERS LOG

Date: Sept 2, 1965, Driller: Porter Drilling, Inc. Wayne

(Name)

(1) Owner of Land:	Description & Color of Materials Sand, Clay, Red Clay, Shell, etc.	Thick- ness Feet	Depth Feet
Walter Dyess (Name)	red clay	10	10
Ok 3 Waynesboro, Miss (Address)	sand + chalk	14	24
(2) Location: NW 1/4, SW 1/4, Sec 26 T 8 R 7	red sand	6	30
3 miles south of Waynesboro (distance) (direction) (Nearest Town)	red clay + sand	2	32
(3) Topography: Hilly (Hilly) (Flat) (Level)	rock	1	33
(4) Purpose of Well: domestic (Domestic Irrigation Municipal, Industrial, Other)	red chalk	20	53
	blue chalk	7	60
	rock	1	61
	fine sand	3	64
	white chalk	3	67
	fine sand	4	71
	chalk	4	75
	thin rock		75
	red chalk	15	90
	fine sandy red sand	10	100
	med clean sand	6	106
	sand + chalk	2	108
	med course clean sand	5	113
	stop while still in sand		

Information upon completion of well:


- (1) Diameter 2" inches.
- (2) Total Depth 113' feet.
- (3) Water Level 78' feet below top of ground.
- (4) Cased to 105', Size 2'
- (5) Screen: Size 1 1/4", Length 5'
- (6) Were any formations sealed against pollution?

yes, X no.

If YES depth of formation

Why

Drillers Remarks:

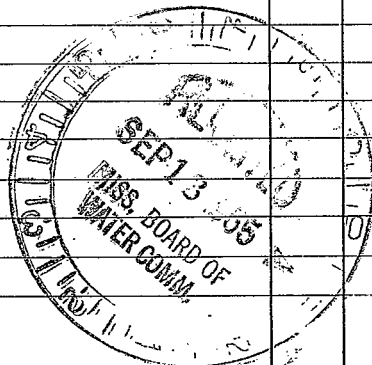

(Use Back Side)

Well No.

