

WAYNE

MISSISSIPPI BOARD OF WATER COMMISSIONERS

N 61

9-21-62

WATER WELL DRILLERS LOG

Date: Sept 21, 1962, Driller: Borden Drilling & Sup. County Wayne
(Name)

(1) Owner of Land: <u>Wayne Feed Store</u> (Name)	Description & Color of Materials Sand, Clay, Red Clay, Shell, etc.	Thick- ness Feet	Depth Feet
<u>Plot 3 Waynesboro, Miss.</u> (Address)	<u>red clay</u>	<u>20</u>	<u>20</u>
	<u>chalk & fine sand</u>	<u>15</u>	<u>35</u>
(2) Location: <u>SE 1/4, NW 1/4, Sec. 27 T8 R 7,</u>	<u>med. fine sand</u>	<u>7</u>	<u>42</u>
<u>4</u> miles <u>SW</u> of <u>Waynesboro</u> (distance) (direction) (Nearest Town)	<u>course sand</u>	<u>8</u>	<u>50</u>
(3) Topography: <u>hilly</u> (Hilly) (Flat) (Level)			
(4) Purpose of Well: <u>Commercial</u> (Domestic Irrigation Municipal, Industrial, Other)			

Information upon completion of well:


- (1) Diameter 2" inches.
- (2) Total Depth 50' feet.
- (3) Water Level 33' feet below top of ground.
- (4) Cased to 44', Size 2"
- (5) Screen: Size 1 1/4", Length 6'
- (6) Were any formations sealed against pollution?
no

yes, no,

If YES depth of formation _____

Why _____

Drillers Remarks: _____

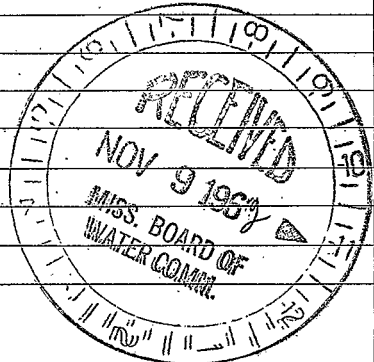

(Use Back Side)

Well No.

