

WAYNE MISSISSIPPI BOARD OF WATER COMMISSIONERS

N 64

11-22-61

WATER WELL DRILLERS LOG

N

Date: Nov 22, 1961, Driller: D. N. Porter Wade County Wayne
 (Name)


	Description & Color of Materials Sand, Clay, Red Clay, Shell, etc.	Thick- ness Feet	Depth Feet
(1) Owner of Land: <u>Wayne Feed Store</u> (Name)	<u>Clay</u>	<u>25</u>	<u>25</u>
<u>Waynesboro Miss</u> (Address)	<u>chall</u>	<u>18</u>	<u>43</u>
(2) Location: <u>SE 1/4, SW 1/4, Sec 27 T8 R 7</u> <u>4</u> miles <u>SW</u> of <u>Waynesboro</u> (distance) (direction) (Nearest Town)	<u>sand</u> <u>stopped on rock</u>	<u>8</u>	<u>51</u>
(3) Topography: <u>hilly</u> (Hilly) (Flat) (Level)			
(4) Purpose of Well: <u>domestic</u> (Domestic Irrigation Municipal, Industrial, Other)			

Information upon completion of well:

- (1) Diameter 2" inches.
- (2) Total Depth 51' feet.
- (3) Water Level 35' feet below top of ground.
- (4) Cased to 45', Size 2"
- (5) Screen: Size 1 1/4", Length 5'
Johnson S.S
- (6) Were any formations sealed against pollution?
 yes, no.

If YES depth of formation _____
 Why _____

Drillers Remarks: _____

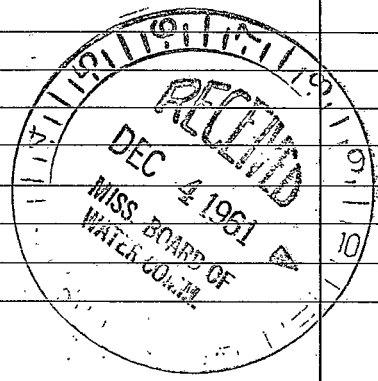

(Use Back Side)

Well No. _____

