

Wayne
 N66
 10-67

MISSISSIPPI
 BOARD OF WATER COMMISSIONERS
 416 North State Street
 Jackson, Mississippi 39201

WATER WELL DRILLERS LOG

Oct 5, 1967 Porter Drilling Co. Wayne
 date well completed firm name county well located

LANDOWNER: Albert Jones

description of formations encountered	from	to
<u>red clay</u>	<u>0</u>	<u>12</u>
<u>sand</u>	<u>12</u>	<u>42</u>
<u>stagnant on rock</u>		

Rt 3 Waynesboro Miss
 (mailing address)

WELL LOCATION:
 sec 30 T 9 N R 7 E
6 miles SW of Waynesboro
 (distance) (direction) (nearest town)

WELL PURPOSE: Home
 (home, irrigation, municipal, industrial)


- WELL COMPLETION DATA:
- (1) diameter (inches) 2'
 - (2) total depth (feet) 30'
 - (3) static water level (feet) 23' below above top of ground.
 - (4) casing steel, 25'
 (material) (depth)
2' if telescope see back.
 (size)
 - (5) screen 5, 25
 (length) (depth to top)
1/4, solid S.S
 (size) (material)
 - (6) pump 1/2 4
 (HP) (yield gpm)
elec
 (type power)
 - (7) electric log no
 (yes or no)
 (organization running log)
 - (8) how well bottom plugged

DRILLERS REMARKS:



If well telescopes please sketch and show depths.

GROUND LEVEL

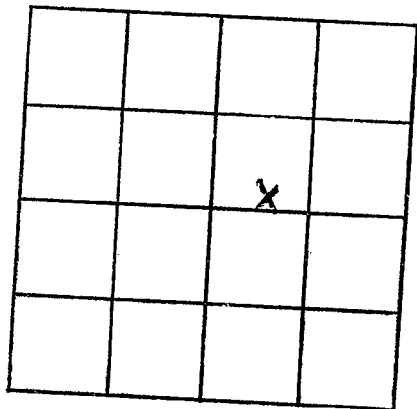

SECTION 30

Please indicate well location X.

ADDITIONAL INFORMATION

If more than one screen, show locations of each on sketch.