

WAYNE

MISSISSIPPI BOARD OF WATER COMMISSIONERS

N 67

4-19-66

WATER WELL DRILLERS LOG


Date April 19, 1966, Driller: Porter Drilling & Svc County Wayne  
(Name)

(1) Owner of Land: <u>James Vaughan Davis</u> (Name)	Description & Color of Materials Sand, Clay, Red Clay, Shell, etc.	Thick- ness Feet	Depth Feet
<u>Pl 3 Waynesboro, Miss</u>	<u>red clay</u>	<u>10</u>	<u>10</u>
<u>SW</u> (Address)	<u>clean fine sand</u>	<u>10</u>	<u>20</u>
(2) Location: <u>1/4, NW 1/4, Sec 32 T8 R 7</u>	<u>red sand</u>	<u>18</u>	<u>38</u>
<u>3</u> miles <u>NW</u> of <u>Clava</u>	<u>clean med. sand</u>	<u>8</u>	<u>46</u>
(distance) (direction) (Nearest Town)	<u>cherty sand</u>	<u>3</u>	<u>49</u>
(3) Topography: <u>hilly</u>	<u>clean med. sand</u>	<u>3</u>	<u>52</u>
(Hilly) (Flat) (Level)	<u>fluffy sand &amp; chert</u>	<u>15</u>	<u>67</u>
(4) Purpose of Well: <u>domestic</u>	<u>red sand</u>	<u>3</u>	<u>70</u>
(Domestic Irrigation Municipal, Industrial, Other)	<u>stop at on rock</u>		

Information upon completion of well:

- (1) Diameter 2" inches.
- (2) Total Depth 64' feet.
- (3) Water Level 30' feet below top of ground.
- (4) Cased to 52', Size 2"
- (5) Screen: Size 1 1/4", Length 12'  
80 ga
- (6) Were any formations sealed against pollution?  
no

If YES depth of formation: \_\_\_\_\_  
Why: \_\_\_\_\_  
Drillers Remarks: \_\_\_\_\_

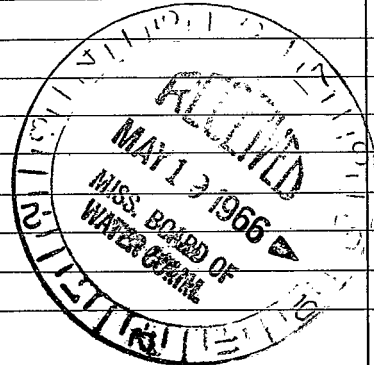

(Use Back Side)

Well No.

