

WAYNE MISSISSIPPI BOARD OF WATER COMMISSIONERS

N 70

2-13-63

WATER WELL DRILLERS LOG

Date: Feb. 13, 1963, Driller: Borth Drilling & Sup. County Wayne
 (Name)

(1) Owner of Land: Jay Odom
 (Name)

Pt 3 Waynesboro
 (Address)

(2) Location: NE 1/4, NW 1/4, Sec. 34 T8R7

4 miles south of Waynesboro
 (distance) (direction) (Nearest Town)

(3) Topography: hilly
 (Hilly) (Flat) (Level)

(4) Purpose of Well: domestic
 (Domestic Irrigation Municipal, Industrial, Other)

Information upon completion of well:

(1) Diameter 2" inches.

(2) Total Depth 60' feet.

(3) Water Level 46' feet below top of ground.

(4) Cased to 54', Size 2"

(5) Screen: Size 1 1/4", Length 6'
60 gr.

(6) Were any formations sealed against pollution?

yes, no.

If YES depth of formation _____

Why _____


Drillers Remarks: _____

Description & Color of Materials
 Sand, Clay, Red Clay, Shell, etc.

Thick-
 ness
 Feet

Depth
 Feet

| | | |
|------------------------------------|-----------|-----------|
| <u>red clay</u> | <u>4</u> | <u>4</u> |
| <u>sand</u> | <u>41</u> | <u>45</u> |
| <u>chalk</u> | <u>3</u> | <u>48</u> |
| <u>sand & streaks of chalk</u> | <u>16</u> | <u>64</u> |
| <u>stopped on rock</u> | | |
| <u>last 4' mostly chalk</u> | | |

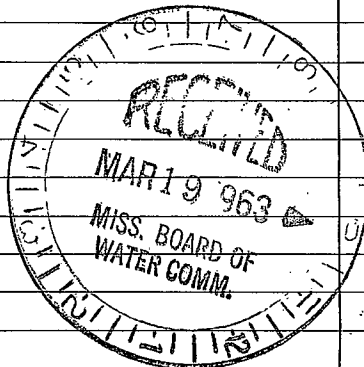

Well No.

(Use Back Side)

Mail this copy to Board of Water Commissioners 429 Miss. St. Jackson, Miss

