

WAYNE MISSISSIPPI BOARD OF WATER COMMISSIONERS

N71

N 308

6-28-61

WATER WELL DRILLERS LOG

Date: June 28, 1961, Driller: D. N. Porter County Wayne
 (Name)

	Description & Color of Materials Sand, Clay, Red Clay, Shell, etc.	Thick- ness Feet	Depth Feet
(1) Owner of Land: <u>Albert Mc Carthy</u> (Name)	Clay	20	20'
<u>Rt 13 Waynesboro, Miss.</u> (Address)	sand & chalk	18	38'
(2) Location: <u>NE 1/4, NW 1/4, Sec. 34 T8 R7</u>	sand with little chalk	8	46'
<u>5</u> miles <u>SW</u> of <u>Waynesboro</u> (distance) (direction) (Nearest Town)			
(3) Topography: <u>hilly</u> (Hilly) (Flat) (Level)			
(4) Purpose of Well: <u>domestic</u> (Domestic Irrigation Municipal, Industrial, Other)			

Information upon completion of well:


- (1) Diameter 2" inches.
- (2) Total Depth 46' feet.
- (3) Water Level 38' feet below top of ground.
- (4) Cased to 40', Size 2"
- (5) Screen: Size 1 1/4 60gr Length 6'
- (6) Were any formations sealed against pollution?

_____ yes, X no.

If YES depth of formation _____

Why _____

Drillers Remarks: _____

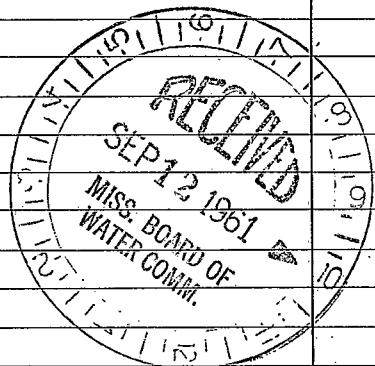

(Use Back Side)

Well No.

