

Wayne
 N 72
 8-67

MISSISSIPPI
 BOARD OF WATER COMMISSIONERS
 416 North State Street
 Jackson, Mississippi 39201

WATER WELL DRILLERS LOG

Aug 3 1967 Porter Drilling Co Wayne
 date well completed firm name county well located

LANDOWNER: J. B. Cooley
Rt 3 Waynesboro, Miss

description of formations encountered

from	to
0	8
8	53

red clay
sand

(mailing address)

WELL LOCATION:

sec 35 T 9 N R 7 E
4 miles S of Waynesboro
 (distance) (direction) (nearest town)


WELL PURPOSE: Home
 (home, irrigation, municipal, industrial)

WELL COMPLETION DATA:

- (1) diameter (inches) 2"
- (2) total depth (feet) 50'
- (3) static water level (feet) 37' below above top of ground.
- (4) casing steel, 45'
 (material) (depth)
2" If telescope see back.
 (size)
- (5) screen 1/4", 45'
 (length) (depth to top)
1/4" S.S.
 (size) (material)
- (6) pump 1/2 6
 (HP) (yield gpm)
elec
 (type power)
- (7) electric log no
 (yes or no)


 (organization running log)
- (8) how well bottom plugged flush point

DRILLERS REMARKS:

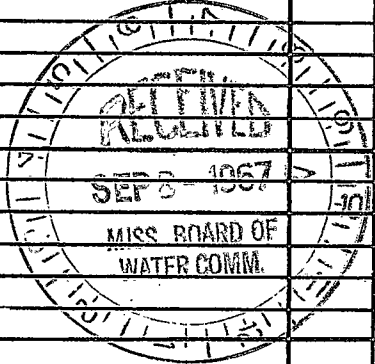

If well telescopes please sketch and show depths.

GROUND LEVEL

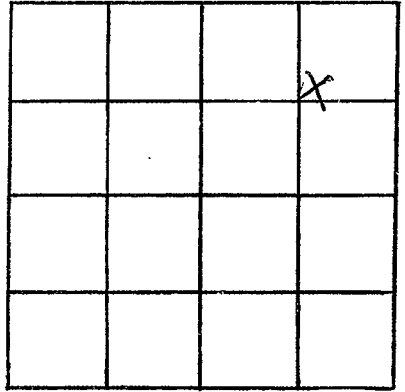

SECTION 35

Please indicate well location X.

ADDITIONAL INFORMATION

If more than one screen,
show locations of each on sketch.