

WAYNE

MISSISSIPPI BOARD OF WATER COMMISSIONERS

N 73

3-5-65

WATER WELL DRILLERS LOG

Date: March 5, 1965, Driller: Port Drilling Inc County: Wayne
(Name)

(1) Owner of Land: E. D. Lassiter
(Name)

Rt 39 Waynesboro, Miss
(Address)

(2) Location: NW 1/4, NW 1/4, Sec 35 T.8.R.7
(Nearest Town)

5 miles south of Waynesboro
(distance) (direction) (Nearest Town)

(3) Topography: hilly
(Hilly) (Flat) (Level)

(4) Purpose of Well: domestic
(Domestic Irrigation
Municipal, Industrial, Other)

Description & Color of Materials Sand, Clay, Red Clay, Shell, etc.	Thick- ness Feet	Depth Feet
<u>med clay</u>	<u>8</u>	<u>8</u>
<u>sand</u>	<u>3.0</u>	<u>38</u>
<u>white chalk</u>	<u>1</u>	<u>39</u>
<u>soft rock</u>	<u>1</u>	<u>40</u>
<u>course red sand</u>	<u>2</u>	<u>42</u>
<u>thin rock</u>		<u>42</u>
<u>chalk</u>	<u>4</u>	<u>46</u>
<u>thin rock</u>		<u>46</u>
<u>fine sand</u>	<u>25</u>	<u>67</u>
<u>white chalk</u>	<u>1</u>	<u>68</u>
<u>med course red sand</u>	<u>10</u>	<u>78</u>
<u>chalky sand</u>	<u>4</u>	<u>82</u>
<u>med course white sand</u>	<u>5</u>	<u>87</u>
<u>mixed but mostly red</u>		
<u>sand</u>	<u>13</u>	<u>100</u>
<u>white chalk</u>	<u>10</u>	<u>110</u>
<u>fine sand</u>	<u>8</u>	<u>118</u>
<u>med white sand</u>	<u>14</u>	<u>132</u>
<u>stopped on chalk</u>		

Information upon completion of well:

(1) Diameter 2" inches.

(2) Total Depth 132' feet.

(3) Water Level 63' feet below top of ground.

(4) Cased to 126', Size 2"

(5) Screen: Size 1 1/4", Length 6'
60 ga.


(6) Were any formations sealed against pollution?

yes, no.

If YES depth of formation _____

Why _____

Drillers Remarks: _____

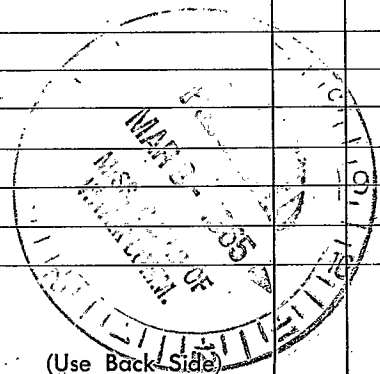

Well No.

(Use Back Side)

