

WAYNE MISSISSIPPI BOARD OF WATER COMMISSIONERS

N 74

6-21-62

WATER WELL DRILLERS LOG

Date: ~~June~~ July 21, 1962, Driller: Porter Drilling & Svc County Wayne
 (Name)

(1) Owner of Land:	Description & Color of Materials Sand, Clay, Red Clay, Shell, etc.	Thick- ness Feet	Depth Feet
<u>Walter Mc Corty</u> (Name)	<u>red clay</u>	<u>20</u>	<u>20'</u>
<u>Box 3 Waynesboro, Miss.</u> (Address)	<u>clack</u>	<u>16</u>	<u>36'</u>
(2) Location: <u>SE 1/4, NW 1/4, Sec. 35 T. 8 R. 7</u>	<u>sand</u>	<u>10</u>	<u>46'</u>
<u>4</u> miles <u>S.</u> of <u>Waynesboro</u> (distance) (direction) (Nearest Town)	<u>stopped while still in sand</u>		
(3) Topography: <u>hilly</u> (Hilly) (Flat) (Level)			
(4) Purpose of Well: <u>domestic</u> (Domestic Irrigation Municipal, Industrial, Other)			


Information upon completion of well:

- (1) Diameter 2" inches.
- (2) Total Depth 46' feet.
- (3) Water Level 17' feet below top of ground.
- (4) Cased to 40', Size 2"
- (5) Screen: Size 1 1/4", Length 6'
- (6) Were any formations sealed against pollution?
 yes, no.

If YES depth of formation _____

Why _____

Drillers Remarks: _____

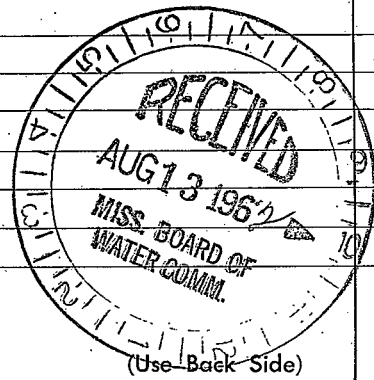

Well No. _____

